ELECTRICAL SYMBOL LIST

LIGHTING SYMBOLS **POWER SYMBOLS** LIGHT FIXTURE, RECESSED RECEPTACLE, DUPLEX +18" A.F.F. LIGHT FIXTURE, RECESSED - EMERGENCY RECEPTACLE, QUAD +18" A.F.F. 0 LIGHT FIXTURE, SURFACE MOUNT RECEPTACLE, DUPLEX +6" ABV COUNTER LIGHT FIXTURE, SURFACE MOUNT - EMERGENCY RECEPTACLE, DUPLEX +18" A.F.F. (ONE OUTLET SWITCHED) LIGHT FIXTURE, STRIP RECEPTACLE, DUPLEX +18" A.F.F. (BOTH OUTLETS SWITCHED) LIGHT FIXTURE, STRIP - EMERGENCY RECEPTACLE, DUPLEX, PEDESTAL MOUNT DOWNLIGHT FIXTURE, RECESSED RECEPTACLE, DUPLEX, FLUSH FLOOR MOUNT DOWNLIGHT FIXTURE, RECESSED, WALLWASH RECEPTACLE, SPECIAL (COORDINATE WITH EQUIPMENT SERVED) DOWNLIGHT FIXTURE, RECESSED - EMERGENCY **—** LIGHT FIXTURE, WALL MOUNT TIME CLOCK CONTROL LIGHT FIXTURE, CEILING MOUNT PUSHBUTTON STATION RECESSED LIGHT FIXTURE, WALL MOUNT JUNCTION BOX LIGHT FIXTURE, WALL MOUNT THERMOSTAT TRANSFORMER LIGHT FIXTURE, WALL SCONCE LIGHT FIXTURE, TRACK W/ HEADS AS SHOWN ON PLAN DISCONNECT, NON-FUSED EXIT SIGN, UNIVERSAL MOUNT, W/ DIRECTIONAL ARROW DISCONNECT, FUSED EXIT SIGN, WALL MOUNT, +8'-0" A.F.F. ELECTRICAL CONNECTION EMERGENCY LIGHT W/ BATTERY PACK, +8'-0" A.F.F. ELECTRICAL CONNECTION, SINGLE MOTOR FLOOD LIGHT ELECTRICAL CONNECTION, MULTI-MOTOR AREA LUMINAIRE ELECTRICAL DISTRIBUTION PANEL, RECESSED AREA LUMINAIRE W/STANDBY LAMP ELECTRICAL DISTRIBUTION PANEL, SURFACE AREA LUMINAIRE, WALL MOUNT AREA LUMINAIRE, POLE MOUNT AREA LUMINAIRE, POST TOP ONE-LINE DIAGRAM SYMBOLS __ELECTRICAL DISTRIBUTION PANELBOARD (MLO) SWITCH SYMBOLS SWITCH, SPST +48" A.F.F. SWITCH, DPST +48" A.F.F. - ELECTRICAL DISTRIBUTION PANELBOARD (MCB) SWITCH, 3-WAY +48" A.F.F. SUB-FEED CIRCUIT BREAKER SWITCH, 4-WAY +48" A.F.F. SWITCH, DIMMER +48" A.F.F. SWITCH, SPST, W/PILOT LIGHT +48" A.F.F. (TRIP RATING & POLES AS INDICATED ON PLAN) SWITCH, KEY-OPERATED +48" A.F.F. SWITCH, TIMED +48" A.F.F. NORM ◆ EMERG PHOTOCELL CONTROL TRANSFER SWITCH (MANUAL OR AUTOMATIC) OCCUPANCY SENSOR CONTROL SIGNAL SYMBOLS GENERATOR (RATING AS INDICATED ON PLAN) TELEPHONE OUTLET +18" A.F.F. DATA OUTLET +18" A.F.F. DATA/TELEPHONE OUTLET +18" A.F.F. TRANSFORMER (RATING AS INDICATED ON PLAN) SIGNAL BELL VISUAL ALARM SIGNAL (COLOR AS INDICATED ON PLAN) GROUND GROUND SYSTEM (SIZE AS INDICATED ON PLAN) P.A. SPEAKER CATV OUTLET (LOCATE AS SHOWN ON PLANS) WATER PIPE GROUND ELECTRODE TRANSIENT VOLTAGE SURGE SUPPRESSOR **NOTATIONS** UTILITY METER & METER BASE C.T. UTILITY METER CURRENT TRANSFORMER DETAIL REFERENCE: TOP=DETAIL NO., BOTTOM=SHEET NO. MECHANICAL EQUIPMENT MARK NO. (SEE EQUIPMENT SCHEDULE) FEEDER NO. (SEE FEEDER SCHEDULE) EQUIPMENT NO. (SEE EQUIPMENT SCHEDULE) **ABBREVIATIONS** LIGHT FIXTURE TYPE (SEE FIXTURE LIST) A.F.F. ABOVE FINISHED FLOOR A.F.G. ABOVE FINAL GRADE

2A-9	WIRING SYMBOLS
410	PANEL & CIRCUIT NUMBER
#10	HOMERUN TO PANEL
	\sim conductor size (if other than #12)
	PHASE CONDUCTOR
	NEUTRAL CONDUCTOR
	GROUND CONDUCTOR
	CONCEALED CONDUIT
71	
/1-1/4"0	
	CONDUIT SIZE
	CONDUIT (UNDER SLAB OR FLOOR)
`	
~~~	FLEXIBLE CONNECTION
<b>—</b> — <b>— →</b>	CONDUIT, STUBBED & CAPPED

		A2
) ED)		A3
ED)		A4
		B1
		B2
		B3
		B4
		B5
AN)		B6
		C1
AN)		C2 C2E
		C3
		U1
		U2
LCP	ISOLATED GROUND LIGHTING CONTROL PANEL MAIN CIRCUIT BREAKER	U3
MLO N.I.C.	MAIN LUGS ONLY NOT IN CONTRACT NIGHT LIGHT	X1 X2
PH R.T.U. U.G. U.O.N. VFD	REMOTE TELEMETRY UNIT UNDERGROUND UNLESS OTHERWISE NOTED VARIABLE FREQUENCY DRIVE	
W W.G.	WIRE GUARD	

W.P. WEATHERPROOF

TRANSFER SWITCH, AUTOMATIC

CLOSED CIRCUIT TELEVISION

CURRENT TRANSFORMER

CONDUIT ONLY

HORSEPOWER


CABLE TELEVISION

TYPE	LAMP	MANUFACTURER	LIGHTING FIXTU	JRE LIST  DESCRIPTION	OPTIONS
A1	LED 3000K 2300LM	NEO RAY LIGHTING (OR APROVED OTHER)	S124DWC575D SERIES	TYPE :4FT GENERAL PURPOSE STRIP MOUNTING :SURFACE HOUSING :STEEL LENS/REFL:ACRYLIC VOLTAGE :MVOLT BALLAST :LED DRIVER	FINISH PER ARCHITECT A1E SHALL HAVE BATTERY BACKUP  EQUIP, & STORAGE ROOMS
A2	LED 3000K 3000LM	LITHONIA LIGHTING (OR APROVED OTHER)	ZL1N-L46 SERIES	TYPE :4FT WALL BRACKET MOUNTING :SURFACE (+7'-0" MIN) HOUSING :STEEL LENS/REFL :ACRYLIC VOLTAGE :MVOLT BALLAST :LED DRIVER	STAIRWELLS
A3	LED 3000K 2850LM	NEO RAY LIGHTING (OR APROVED OTHER)	S124RD1P SERIES	TYPE :4FT DIRECT/INDIRECT MOUNTING :SUSPENDED HOUSING :STEEL LENS/REFL :ACRYLIC VOLTAGE :MVOLT BALLAST :LED DRIVER	FINISH PER ARCHITECT MOUNTING HEIGHT PER ARCHITECT  AMENITY SPACES
A4	LED 4000K 3000LM	LITHONIA LIGHTING (OR APROVED OTHER)	FEML48 SERIES	TYPE :4FT ENCLOSED STRIP MOUNTING :SURFACE HOUSING :FIBERGLASS LENS/REFL :ACRYLIC VOLTAGE :MVOLT BALLAST :LED DRIVER	ELEVATOR PIT, TOP OF SHAFT
B1	LED 3000K	HYDREL LIGHTING (OR APROVED OTHER)	LOWELL SERIES	TYPE :EXTERIOR SCONCE (UP/DWN) MOUNTING :SURFACE HOUSING :ALUMINUM LENS/REFL :CLEAR TEMPERED GLASS VOLTAGE :MVOLT	FINISH PER ARCHITECT MOUNT AT+7'-0" ABOVE GRADE TO CENTER OF FIXTURE  UL LISTED WET LOCATION
B2	12W LED 3000K 2900LM	LITHONIA LIGHTING (OR APROVED OTHER)	WXP1LED GERIES	BALLAST :LED DRIVER  TYPE :EXTERIOR WALL PACK MOUNTING :SURFACE (+7'-0") HOUSING :ALUMINUM LENS/REFL :ACRYLIC VOLTAGE :MVOLT BALLAST :LED DRIVER	BUILDING FACADE, ROOF  TYPE III DISTRIBUTION  ROOF
В3	LED 3000K 750LM	LITHONIA LIGHTING (OR APROVED OTHER)	LDN6CYL SERIES	TYPE :6" DIA EXTERIOR CYLINDER MOUNTING :SURFACE HOUSING :ALUMINUM LENS/REFL :MATTE DIFFUSER VOLTAGE :MVOLT BALLAST :LED DRIVER	FINISH PER ARCHITECT WIDE FLOOD  UL LISTED WET LOCATION ENTRY CANOPY
B4	LED 3000K 2420LM	GLOWBACK LED (OR APROVED OTHER)	LVLBP1.5 SERIES	TYPE :4FT LINEAR CEILING LIGHT MOUNTING :SURFACE HOUSING :ALUMINUM LENS/REFL :MATTE DIFFUSER VOLTAGE :MVOLT BALLAST :LED DRIVER	FINISH PER ARCHITECT  UL LISTED WET LOCATION ENTRY CANOPY
B5	LED 3000K	FOCUS INDUSTRIES (OR APROVED OTHER)	DL-22 SERIES	TYPE :LANDSCAPE LIGHT MOUNTING :AT GRADE HOUSING :BRASS LENS/REFL: VOLTAGE :12V BALLAST :LED DRIVER	FINISH PER ARCHITECT PROVIDE ALL COMPONENTS FOR COMPLETE INSTALLATION. FIELD ADJUST UL LISTED WET LOCATION COURTYARD
B6	LED 3000K 2250LM	HYDREL LIGHTING (OR APROVED OTHER)	M9410C SERIES	TYPE :ADJUSTABLE IN-GROUND LIGHT MOUNTING :AT GRADE HOUSING :BRASS LENS/REFL: VOLTAGE :MVOLT BALLAST :LED DRIVER	FINISH PER ARCHITECT FIELD ADJUST  UL LISTED WET LOCATION LANDSCAPE BED
C1	LED 3000K 1075LM	USAI LIGHTING (OR APROVED OTHER)	P4RDF SERIES	TYPE :4.5" DIA DOWNLIGHT MOUNTING :RECESSED HOUSING :STEEL LENS/REFL :NA VOLTAGE :MVOLT	FINISH PER ARCHITECT C1E SHALL HAVE BATTERY BACKUP
	9W	LICAL LIQUENO	DZDD OFFICE	BALLAST :LED DRIVER	LOBBY, CORRIDORS
C2 C2E	LED 3000K 1175LM 9W	USAI LIGHTING (OR APROVED OTHER)	P3RD SERIES	TYPE :3" DIA DOWNLIGHT MOUNTING :RECESSED HOUSING :STEEL LENS/REFL :NA VOLTAGE :MVOLT BALLAST :LED DRIVER	FINISH PER ARCHITECT C2E SHALL HAVE BATTERY BACKUP LOBBIES
C3	LED 3000K 935LM	SUNPARK LIGHTING (OR APROVED OTHER)	FL0324D-VT SERIES	TYPE :2FT VANITY LIGHT MOUNTING :SURFACE (+6" ABOVE MIRROR) HOUSING :STEEL LENS/REFL:ACRYLIC VOLTAGE :MVOLT BALLAST :LED DRIVER	RESTROOM
U1	LED 2700K 1000LM	DESIGN CLASSICS (OR APPROVED OTHER)	DFR615-H-927-WH	TYPE :6" DIA CEILING LIGHT MOUNTING :SURFACE HOUSING :ALUMINUM LENS/REFL :ACRYLIC VOLTAGE :120V	UL LISTED WET LOCATION
U2	15W LED 3000K 1600LM 20W	KUZCO LIGHTING (OR APPROVED OTHER)	FM3511 SERIES	BALLAST :LED DRIVER (0-10 DIMMING)  TYPE :11" DIA CEILING LIGHT MOUNTING :SURFACE HOUSING :STEEL LENS/REFL :FROSTED GLASS VOLTAGE :120V BALLAST :LED DRIVER (0-10 DIMMING)	UNIT KITCHEN, BATH, HALL FINISH PER ARCHITECT  UNIT BEDROOM
U3	LED 3000K 1600LM	KUZCO LIGHTING (OR APPROVED OTHER)	VL62220 SERIES	TYPE :20" VANITY BAR MOUNTING :SURFACE (=6" ABOVE MIRROR) HOUSING :STEEL LENS/REFL :ACRYLIC VOLTAGE :120V BALLAST :LED DRIVER (0-10 DIMMING)	FINISH PER ARCHITECT  UNIT BATHROOM
X1 X2	LED (GREEN LETTERS)	LITHONIA ) DMF LIGHTING (OR APROVED OTHER)	LE EL N SERIES DLED500EM-G	TYPE :EXIT SIGN MOUNTING :UNIVERSAL HOUSING :DIE—CAST ALUMINUM LENS/REFL :SINGLE FACE/DUAL FACE VOLTAGE :MVOLT BALLAST :NICKLE CADMIUM BATTERY	X1=SINGLE SIDE X2=DOUBLE SIDE

#### GENERAL LIGHTING NOTES:

ARCHITECT PRIOR TO ROUGH IN.

- A. WHEREVER POSSIBLE, SELECTED LIGHT FIXTURES SHALL HAVE ENERGY EFFICIENT LAMPS, BALLASTS & DRIVERS AND/OR HAVE ENERGY COMPLIANT RATINGS SUCH AS DLC, ENERGY STAR, ETC.
- B. VERIFY ALL FIXTURE FINISHES WITH ARCHITECT PRIOR TO BID.
- C. VERIFY ALL FIXTURE LOCATIONS AND MOUNTING HEIGHTS WITH
- D. ALL LIGHTING SHALL BE 3000 KELVIN UNLESS OTHERWISE NOTED.
- E. ALL PRODUCT SUBSTITUTIONS AND VALUE ENGINEERING SHALL BE SUBMITTED DURING BID PHASE, SHALL MEET DESIGN INTENT AND ARE SUBJECT TO OWNER APPROVAL.
- F. EGRESS LIGHTING SHALL BE PROVIDED TO MEET MINIMUM LIGHT LEVELS AS DESCRIBED PER OREGON STRUCTURAL SPECIALTY CODE
- G. BUILDING EXTERIOR & SITE LIGHTING SHALL BE CONTROLLED VIA PHOTOCELL, EITHER INTEGRAL OR REMOTE, OR BY TIME CLOCK FOR DUSK-TILL-DAWN OPERATION.
- H. LIGHTING FIXTURES DESIGNATED AS NIGHT LIGHTS (N.L.) AND STAIRWELL LIGHTS SHALL BE ON 24/7.
- STAIRWELL LIGHTS SHALL BE PROVIDED WITH OCCUPANCY SENSOR(S), EITHER INTEGRAL OR REMOTE, TO PROVIDE 50% LIGHT REDUCTION DURING PERIODS OF INACTIVITY. ONCE ACTIVATED, LIGHTS ARE TO REMAIN AT 100% OUTPUT FOR A MINIMUM OF 20
- DESIGN INTENT FOR CORRIDOR LIGHT FIXTURES TO BE CONTROLLED SUCH THAT THE FIXTURES DIM BY 50% DURING PERIODS OF LOW ACTIVITY. UPON DETECTION, LIGHTS SHALL RETURN TO 100% AND REMAIN AT FULL OUTPUT FOR A MINIMUM OF 30 MINUTES BEFORE RETURNING TO THE DIMMED STATE. FIXTURES ON EMERGENCY POWER CIRCUITS SHALL REMAIN 'ON' 24/7.

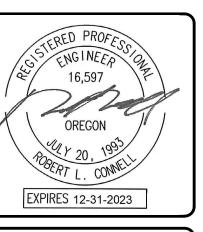


0



PHN: (503) 234-0548 FAX: (503) 234-0677 WWW.MFIA-ENG.COM

OF ****

NOTE: SOME OF THE SYMBOLS AND ABBREVIATIONS ON THIS LIST MAY NOT APPLY TO THIS PROJECT.

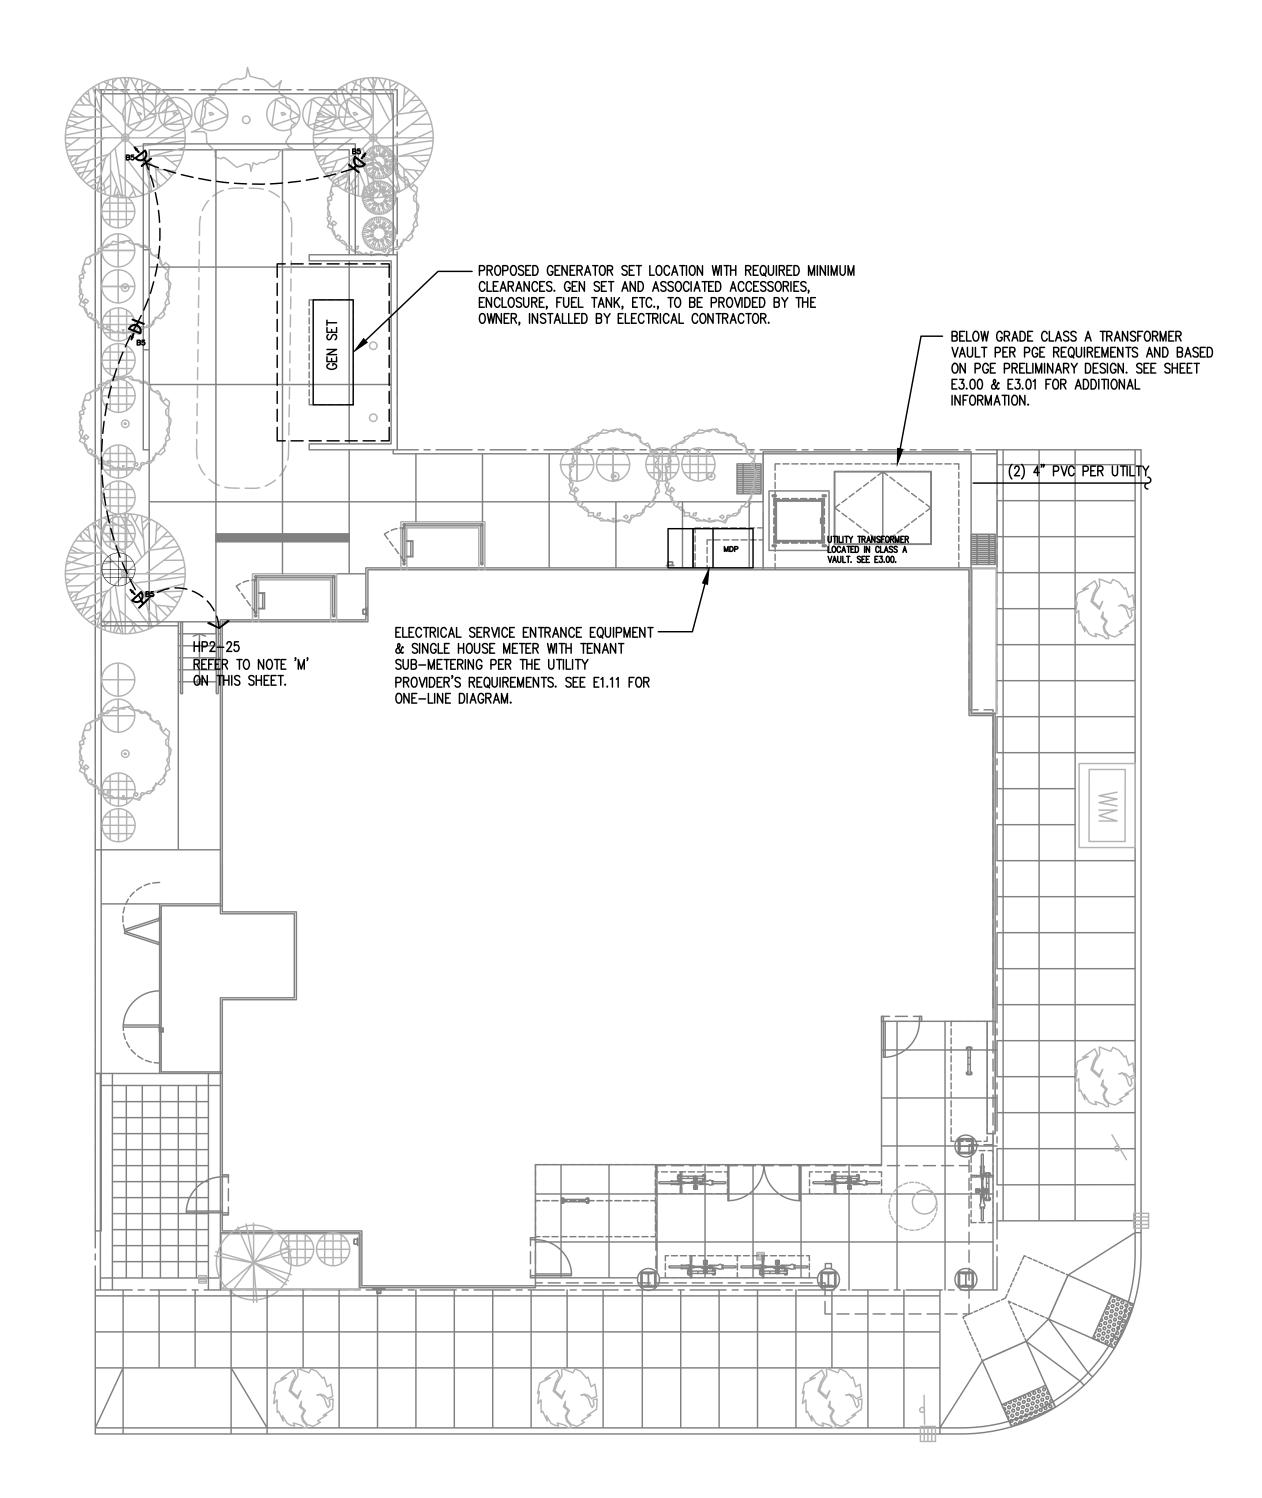



### GENERAL NOTES:

- A. ALL WORK SHALL BE PERFORMED IN ACCORDANCE WITH ALL APPLICABLE LOCAL, STATE AND NATIONAL CODES.
- B. ELECTRICAL PLANS ARE DIAGRAMMATIC AND MAY OR MAY NOT REFLECT ACTUAL FIELD CONDITIONS.
- C. REFER TO LIGHTING PLANS FOR BUILDING MOUNTED LIGHT FIXTURE LOCATIONS.
- D. COORDINATE WITH LOCAL UTILITY PROVIDER FOR EXACT SERVICE CONDUIT AND CONDUCTORS REQUIREMENTS.
- E. ALL UTILITY WORK SHALL BE DONE IN ACCORDANCE WITH CLARK PUBLIC UTILITIES ELECTRICAL SERVICE REQUIREMENTS.
- F. U.G. PRIMARY FEEDER SHALL HAVE A MINIMUM 48 INCH BURY.
- G. U.G. SECONDARY FEEDER SHALL HAVE A MINIMUM 36 INCH BURY.
- H. REFER TO SHEET E1.11 FOR ONE-LINE DIAGRAM, LOAD SUMMARY INFORMATION AND TYPICAL FEEDER SCHEDULE.
- I. SECONDARY CONDUIT SWEEPS SHALL BE MINIMUM 60 INCH RADIUS WITH A MINIMUM OF 7'-0" STRAIGHT CONDUIT RUN BETWEEN SWEEPS.
- J. CONTRACTOR SHALL REVIEW THE UTILITY PROVIDER'S ELECTRICAL SERVICE REQUIREMENTS PRIOR TO THE START OF ANY WORK.
- K. LOCATION AND INSTALLATION OF THE PRIMARY AND SECONDARY CONDUITS, TRANSFORMER, ETC. SHALL BE PROVIDED PER UTILITY PROVIDER'S ELECTRICAL SERVICE REQUIREMENTS.
- L. CONTRACTOR SHALL REVIEW ALL PROJECT DOCUMENTS AND SPECIFICATIONS IN DETAIL AND REFER TO THE DOCUMENTS THROUGHOUT THE CONSTRUCTION.
- M. VERIFY LOW VOLTAGE LANDSCAPE LIGHTING FIXTURES & LOCATIONS AND PROVIDE POWER CONNECTIONS AS REQUIRED PER THE LANDSCAPE PLAN SET.

### UTILITY REQUIREMENTS

1. CUSTOMER TO PROVIDE ALL TRENCHING AND BACKFILLING. TRENCH TO BE 36 INCHES DEEP AND 30 INCHES WIDE, MEASURED FROM FINAL GRADE.

2. ALL UTILITY CONDUCTORS TO BE INSTALLED IN GRAY SCHEDULE 40, ELECTRICAL GRADE, PVC CONDUIT WITH NYLON PULL STRINGS (MIN 500 LBS. TEST). CLARK PUBLIC UTILITIES TO DETERMINE THE SIZE AND NUMBER OF CONDUITS REQUIRED. ALL ELBOWS TO BE 36 INCH (MIN) RADIUS. ALL BENDS MAY BE FACTORY MADE. IF MORE THAN 270 DEGREES OF BENDS OR IF RUN IS LONGER THAN 150 FEET, BENDS MUST BE RIGID STEEL.

3. CONSULT WITH UTILITY REPRESENTATIVE 2 WEEKS BEFORE STARTING MAIN POWER TRENCHING FOR A PRE-CONSTRUCTION CONFERENCE. INCLUDED IN THIS CONFERENCE WILL BE EXCAVATOR, CPU, TELCO, CATV, AND GAS.


4. CONTRACTOR TO LOCATE ALL UNDERGROUND UTILITIES BEFORE TRENCHING.

# CLASS A TRANSFORMER VAULT ROOM GENERAL NOTES:

- 1. ALL MATERIALS AND PRODUCTS USED WITHIN THE CLASS A VAULT IS SUBJECT TO THE UTILITY PROVIDER'S APPROVAL.
- 2. PRIMARY SERVICE CONDUCTORS FROM THE PROPERTY LINE TO THE VAULT SHALL BE IN SCHEDULE 40 PVC PER THE UTILITY PROVIDER'S DIRECTION. ALL CONDUIT PENETRATIONS MUST BE SEALED WITH A FLEXIBLE NON-SHRINK HYDROPHOBIC GROUT TO PREVENT WATER INTRUSION.
- 3. NON-METALIC SEISMIC-APPROVED CABLE TRAY WITH GALVANIZED HARDWARE SHALL BE INSTALLED IN VAULT ROOMS WITH CEILING GREATER THAN 10 FEET HIGH.
- 4. VAULT ROOM DOORS SHALL BE BLAST-RATED METAL DOORS. DOORS AND VENT SHUTTERS MUST HAVE A THREE HOUR BLAST & FIRE RATING PER NFPA 450.43.
- 5. ALL OPENING, GAPS & CRACKS MUST BE SEALED WITH THREE—HOUR RATED FIRE CAULKING. CONSULT UTILITY PROVIDER FOR APPROVED PRODUCTS.
- 6. PROVIDE TWO "RATE TO RISE" HEAT DETECTORS PER THE UTILITY PROVIDER'S REQUIREMENTS. LOCATE ONE ABOVE THE TRANSFORMER AND ONE OTHER WITHIN THE ROOM.

  7. VAULT VENTS MUST HAVE SHUTTERS THAT ARE AUTOMATICALLY CLOSED BY THE HEAT
- DETECTOR IN THE FIRE SUPPRESSION SYSTEM HEAT DETECTORS SHALL MEET NFPA 72 REQUIREMENTS.

8. REFER TO SHEETS E3.00 & E3.01 FOR MORE INFORMATION REGARDING THE CLASS 'A' TRANSFORMER VAULT ROOM.

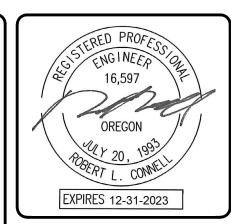

OREGON

R APARTMENT
RYSTADT
SW PARK AVE.

S

Q


20

Consulting Engineers 2007 S.E. Ash St. Portland, OR 97214 PHN: (503) 234-0548 FAX: (503) 234-0677

WWW.MFIA-ENG.COM

SHEET

E1.01

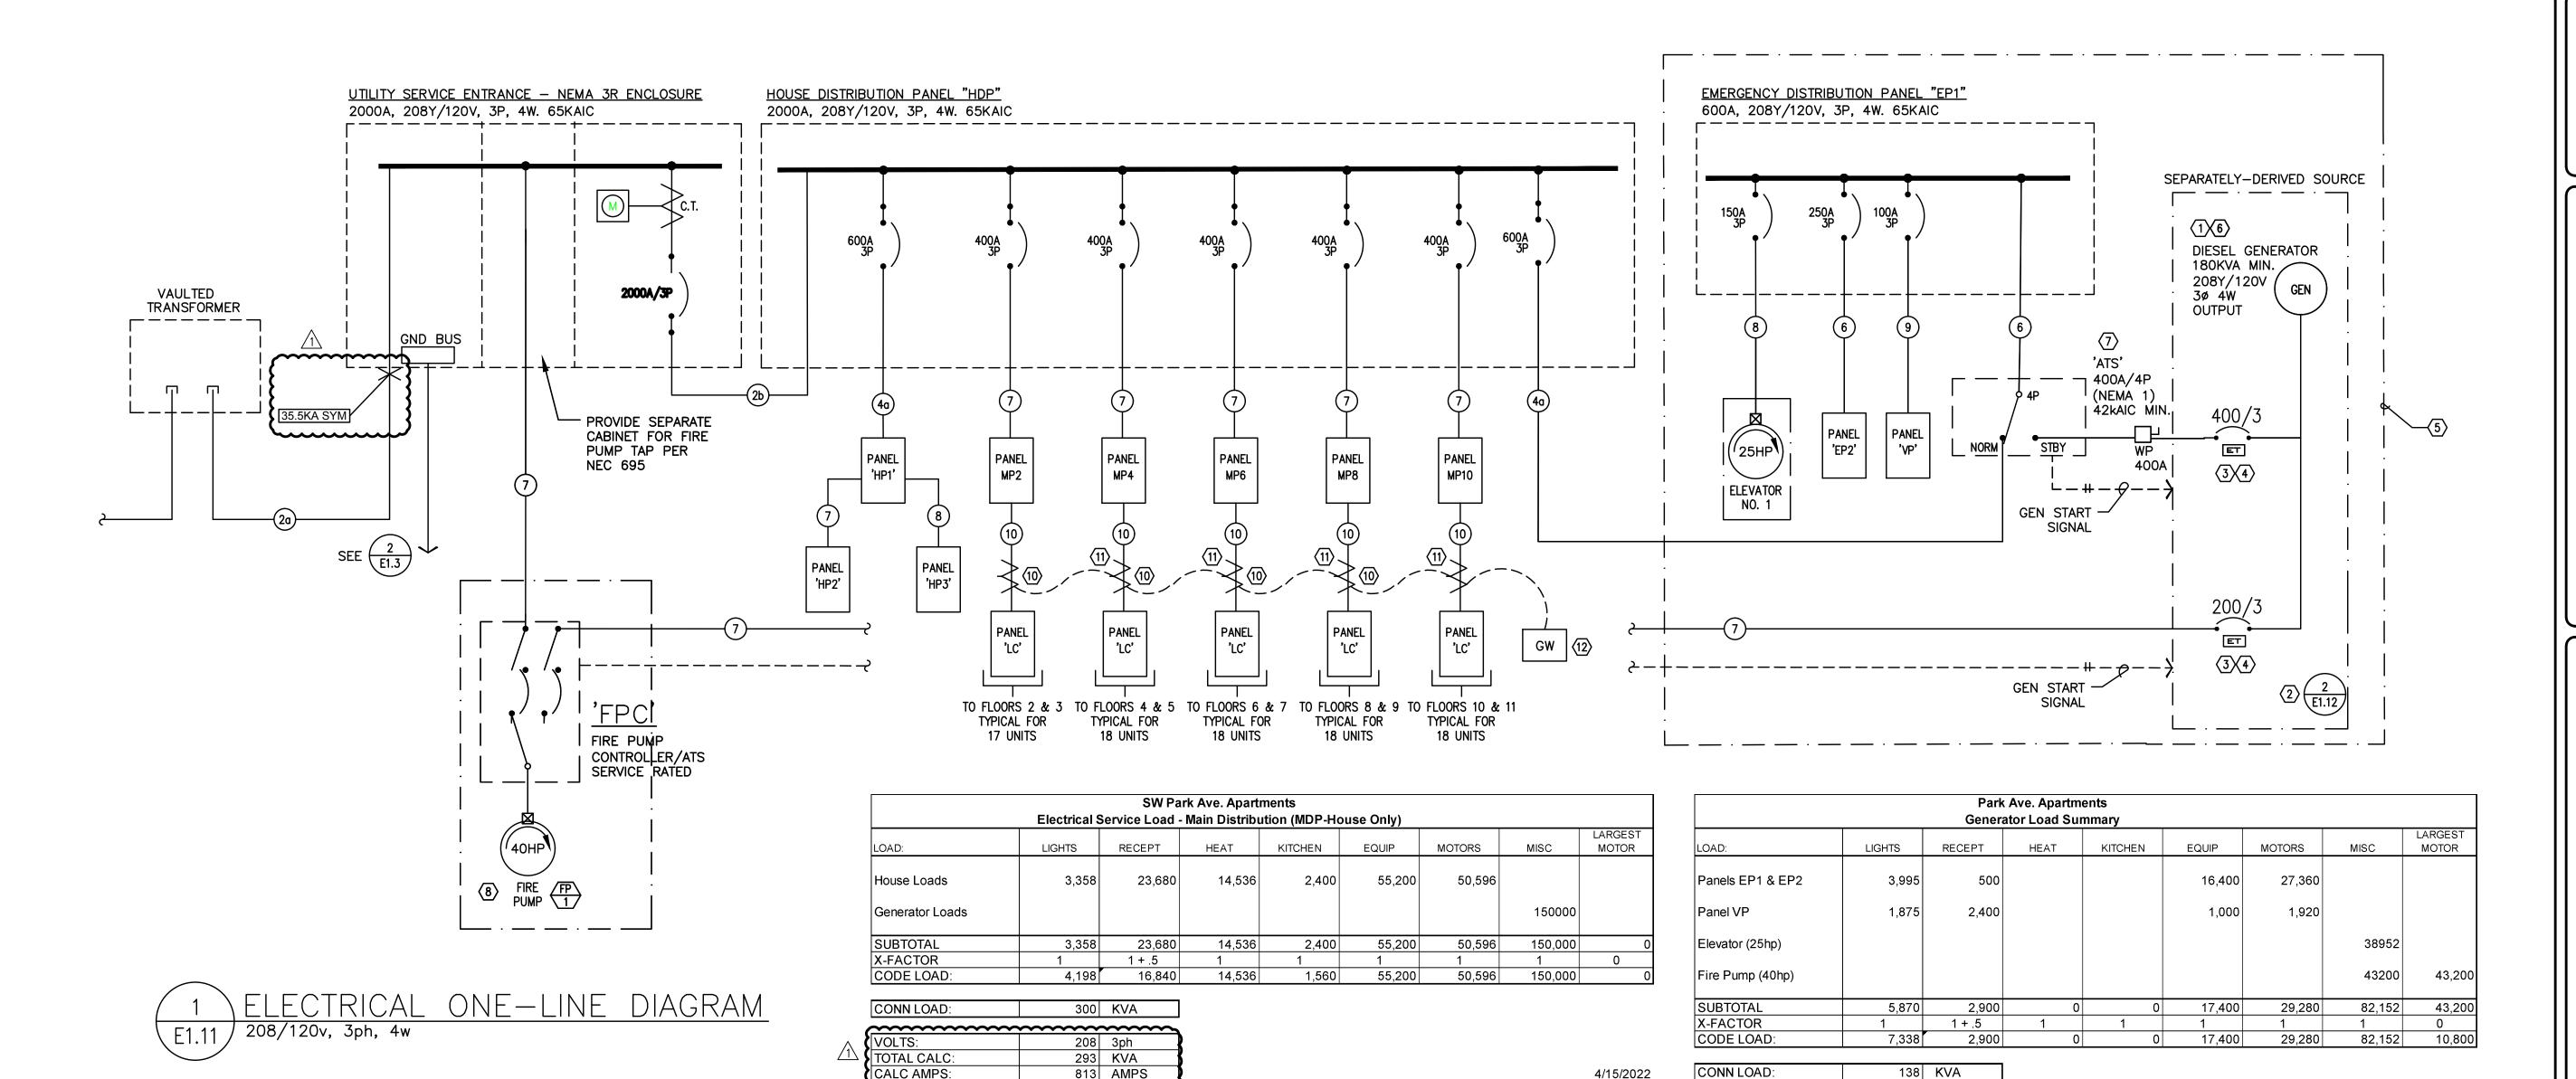

	FE	EDER S	SCHEDULE (C	Ю	PPER	
NO.	AMPS	CONDUIT	CONDUCTOR			
1		PRIMARY	BY UTILITY CO.	&		GND
20		*(12) 5"	BY UTILITY CO.	&		GND
<b>2b</b>	2500A	*(6) 4"	ea w/ (4) #600Kcm	&	(1) #350k	(GMD
3	1200A	*(3) 4"	ea w/ (4) #600Kcm	&	(1) #3/0	GND
4	800A	*(2) 4"	ea w/ (4) #600Kcm	&	(1) #1/0	GND
40	600A	*(2) 3"	ea w/ (4) #350Kcm	&	(1) #1	GND
5	400A	3 1/2"	(4) #500Kcm	&	(1) #3	GND
6	250A	2 1/2"	(4) #250Kcm	&	(1) #4	GND
7	200A	2"	(4) #3/0	&	(1) #6	GND
8	150A	2"	(4) #1/0	&	(1) #6	GND
9	100A	1 1/2"	(4) #1	&	(1) #8	GND
10	100A	1 1/2"	(3) #1	&	(1) #8	GND

* PARALLEL FEEDER

### ONE-LINE GENERAL NOTES:

A. COORDINATE ALL WORK ASSOCIATED WITH ELECTRIC SERVICE WITH LOCAL UTILITY PROVIDER. PROVIDE ALL CONDUIT, GROUNDING, TRANSFORMER VAULT/PAD, ETC., IN ACCORDANCE WITH SERVING UTILITY REQUIREMENTS.

#### B. COORDINATE METERING REQUIREMENTS WITH UTILITY.

C. FOR LOAD CENTER FEEDER LENGTHS GREATER THAN 145'-0" FROM METER CENTER, INCREASE WIRE SIZE ONE SIZE UP FOR VOLTAGE DROP.

D. PER NEC 240.87, THE ELECTRICAL CONTRACTOR SHALL PROVIDE DOCUMENTATION FOR ARC ENERGY REDUCTION DEVICE(S) FOR CIRCUIT BREAKERS 1200A OR GREATER, CONTRACTOR SHALL PROVIDE AN ENERGY-REDUCING ACTIVE FLASH MITIGATION SYSTEM OR OTHER METHOD APPROVED BY THE NEC.

E. USE OF ALUMINUM CONDUCTORS, AS ALLOWED BY CODE, MAY BE SUBSTITUTED FOR COPPER. CONTRACTOR SHALL PROVIDE WRITTEN SUBSTITUTION REQUEST DEMONSTRATING THE THAT THE PROPOSED PRODUCT IS EQUIVALENT TO COPPER IN ALL ASPECTS.

F. ACCEPTABLE POWER MONITORING SYSTEM MANUFACTURERS ARE: SIEMENS SEM3 E-MON D-MON SQUARE D POWERLOGIC OR AS APPROVED BY SUBMITTAL PROCESS.

### O ONE-LINE NOTES:

- 1. ESTIMATED GENERATOR STARTING LOAD IS BASED ON THE ELEVATOR & FIRE PUMP MOTORS BEING PROVIDED WITH REDUCED STARTING.
- 2. PROVIDE GROUND FOR SEPARATELY DERIVED SYSTEM PER NEC.
- 3. PROVIDE ELECTRONIC TRIP CIRCUIT BREAKER. EXACT BREAKER TYPE, SETTINGS, ETC. TO BE VERIFIED AND AS DETERMINED BY SELECTIVE COORDINATION STUDY AS PERFORMED BY THE ELECTRICAL DISTRIBUTION EQUIPMENT MANUFACTURER.
- 4. COORDINATE INSTALLATION OF OUTPUT BREAKERS WITH GENERATOR MANUFACTURER TO SELECTIVELY COORDINATE WITH POWER STUDY RECOMMENDATIONS.
- 5. 'LIFE SAFETY' BRANCH TO MEET ALL REQUIREMENTS OF NEC 700. CONTRACTOR SHALL BE AWARE THAT MFIA HAS ATTEMPTED TO INDICATE EQUIPMENT AND SIZES THAT WILL SELECTIVELY COORDINATE, BUT WILL NOT BE KNOWN UNTIL ELECTRICAL EQUIPMENT MANUFACTURER PERFORMS THE REQUIRED POWER STUDIES AS SPECIFIED IN 26 05 73. CHANGES MAY BE NECESSARY AFTER THE BID.
- 6. GENERATOR IS SIZED TO OPERATE ONLY ONE ELEVATOR AT A TIME. COORDINATE WITH ELEVATOR & GENERATOR PROVIDERS FOR AUTOMATIC SEQUENTIAL OPERATION AS REQUIRED UNDER ASME A17.1, SECTION 2.27.2.1 THROUGH 2.27.2.5.
- 7. THE AUTOMATIC TRANSFER SWITCH FOR THE EMERGENCY PANEL "EDP" SHALL OPERATE SUCH THAT THE EGRESS LOADS ARE SWITCHED TO GENERATOR POWER WITHIN 10 SECONDS AND THE ELEVATOR(S) SWITCHED WITHIN 60 SECONDS OF A POWER FAILURE.

8. CONSULT MECHANICAL, PLUMBING AND/OR FIRE ALARM PLANS AND VERIFY EXACT POWER REQUIREMENTS FOR THE FIRE PUMP.

4/15/2022

- 9. CONSULT ELEVATOR PROVIDER FOR INSTALLATION AND POWER REQUIREMENTS PRIOR TO ROUGH IN.
- 10. PROVIDE CIRCUIT BREAKER WITH INTEGRAL LOAD MONITORING MODULE COMPATIBLE WITH POWER MONITORING SYSTEM. SEE MANUFACTURER SPECIFICATIONS FOR WEB BASED POWER MONITORING SYSTEM REQUIREMENTS.
- 11. SERIAL COMMUNICATIONS CABLE, 18 AWG MINIMUM. BELDEN 9463 OR APPROVED.
- 12. PROVIDE LOAD MONITORING NETWORK GATEWAY COMPATIBLE WITH POWER MONITORING SYSTEM.

208 3ph

150 KVA 416 AMPS

TOTAL CALC

CALC AMPS:

13. GENERATOR SET AND ALL ASSOCIATED COMPONENTS AND ACCESSORIES TO BE PROVIDED BY OWNER. THE ELECTRICAL CONTRACTOR SHALL PROVIDE INSTALLATION, POWER CONNECTIONS, COORDINATION AND TESTING AS REQUIRED FOR A COMPLETE INSTALLATION. CONSULT MANUFACTURER'S DOCUMENTATION AND DIVISION 26 SPECIFICATIONS FOR ADDITIONAL INFORMATION.



GRAM 0 **E** (0) 5 0

INC.

Consulting Engineers 2007 S.E. Ash St. Portland, OR 97214 PHN: (503) 234-0548 FAX: (503) 234-0677 WWW.MFIA-ENG.COM

SHEET

	panel		mountin	ıg		location	1		connected load amps	
	EP1		SURFA	CE		ELECT.	. ROOM			232
	voltage		phase		b	us & ma	iin		calculated load amps	
	120/208V (SCCR: 42KAIC)		3		400A			MLO		262
С	service	va	a/p	no.	abc	no.	a/p	va	service	(
6	ELEVATOR	9384	150/3	1	*	2	250/3	16844	PANEL EP2	
6	*	9384	*	3	*	4	*	16868	*	
6	*	9384	*	5	*	6	*	14920	*	
	SPARE		20/1	7	*	8	100/3	2700	PANEL VP	
	SPARE		20/1	9	*	10	*	3620	*	
	SPARE		20/1	11	*	12	*	500	*	
	BLANK			13	*	14			BLANK	
	BLANK			15	*	16			BLANK	
	BLANK			17	*	18			BLANK	
	BLANK			19	*	20			BLANK	
	BLANK			21	*	22			BLANK	
	BLANK			23	*	24			BLANK	
	BLANK			25	*	26			BLANK	
	BLANK			27	*	28			BLANK	
	BLANK			29	*	30			BLANK	
	BLANK			31	*	32			BLANK	
	BLANK			33	*	34			BLANK	
	BLANK			35	*	36			BLANK	
	BLANK			37	*	38			BLANK	
	BLANK			39	*	40			BLANK	
	BLANK			41	*	42			BLANK	
	Phase A	28928	VA		1	NOTES:	:		line-line voltage	I
	Phase B	29872	VA							208
	Phase C	24804	VA						largest motor (va)	
	Total Connected	83604	VA							43200
	load code:	ph. A	ph. B		ph. C		total	factor	calculated load (va)	
	1. LIGHTS=	0	0		0	VA	0	1.25		0
	2. RECEPT.=	0	о		0	VA	О	1 + 0.5		0
	3. HEATING=	0	о		0	VA	О	1.00		0
	4. KITCHEN=	0	о		0	VA	О	1.00		0
	5. EQUIP.=	0	о		0	VA	О	1.00		0
	6. MOTORS=	9384	9384		9384	VA	28152	*		38952
	7. MISC=	19544	20488		15420	VA	55452	1.00		55452
-	(* 125% of the largest motor + 100%	of the b	alance)				-	TOTAL =	:	94404


EP2         SURFACE         ELECT. ROOM         135           voltage         phase         bus & main         calculated load amps           120/208V (SCCR: 42KAIC)         3         250A         MLO         137           C         service         va         a/p         no.         a b c         no.         a/p         va         service		panel		mountin	a		location	1		connected load amps	_
120/208V (SCCR: 42KAIC)   23   250A		·		l	-		ELECT	. ROOM		•	5
120/208V (SCCR: 42KAIC)						T bi				calculated load amps	_
C   Service   Va   A/p   No.   a b c   No.   a/p   Va   Service		· ·		Ľ		250A			MLO	· '	7
1   LIGHTS - BLDG EXTERIOR   206   20/1   1   *   2   20/1   1200   ELEV. CONTROL PANEL     LIGHTS - STAIR #2   744   20/1   3   *   4   20/1   1200   ELEV. CAB LIGHTS     LIGHTS - STAIR #1   806   20/1   5   *   6   20/1   1500   GENERATOR BLOCK HEATER     ELEV PITS & LTS (PIT & SHAFT)   500   20/1   7   *   8   20/1   1500   GENERATOR BLOCK HEATER     ELEV PITS & LTS (PIT & SHAFT)   500   20/1   7   *   8   20/1   1500   GENERATOR BLOCK HEATER     LIGHTS - FLRS 3,4,5   210   20/1   11   *   12   20/1   1176   SP-1 (ELEV PIT)     LIGHTS - FLRS 6,7,8   210   20/1   11   *   12   20/1   176   SP-1 (ELEV PIT)     LIGHTS - FLRS 9,10,11,12,ROOF   300   20/1   15   *   16   20/1   500   GENERATOR BATTERY CHARGER     LIGHTS - FLRS 9,10,11,12,ROOF   300   20/1   17   *   18   20/1   500   GENERATOR REMOTE ANNUNC     DOOR OPENERS   1500   20/1   17   *   18   20/1   500   GENERATOR REMOTE ANNUNC     SMOKE CURTAINS   1500   20/1   21   *   22   20/1   176   SP-3     SMOKE CURTAINS   1500   20/1   21   *   22   20/1   176   SP-3     SMOKE CURTAINS   1500   20/1   27   28   *   3864   SF-3 STAIR PRESSURIZATION FAN     SMOKE DAMPERS   1500   20/1   27   28   *   3864   SF-3 STAIR PRESSURIZATION FAN     SPARE   0   20/1   29   *   30   *   3864   SF-4 STAIR PRESSURIZATION FAN     SPARE   0   20/1   29   *   30   *   3864   SF-4 STAIR PRESSURIZATION FAN     BLANK   35   36   *   3864   SF-4 STAIR PRESSURIZATION FAN     BLANK   37   *   38   BLANK   B	С		va	a/p	no.	abc	no.	a/p	va	service	Т
LIGHTS - STAIR #1	1	LIGHTS - BLDG EXTERIOR	206		1	*	2	20/1	1200	ELEV. CONTROL PANEL	†
ELEV PITS & LTS (PIT & SHAFT)	1	LIGHTS - STAIR #2	744	20/1	3	*	4	20/1	1200	ELEV. CAB LIGHTS	†
LIGHTS - BSMNT, FLR 1 & 2   220   20/1   9   *   10   20/1   500   FACP/VOICE EVAC     LIGHTS - FLRS 3,4,5   210   20/1   11   *   12   20/1   1176   SP-1 (ELEV PIT)     LIGHTS - FLRS 6,7,8   210   20/1   13   *   14   20/1   500   RECEPT - ELEV MACH RM     LIGHTS - FLRS 9,10,11,12,ROOF   300   20/1   15   *   16   20/1   500   STAIR #1 DAMPERS     DOOR OPENERS   1500   20/1   17   *   18   20/1   500   STAIR #1 DAMPERS     SMOKE CURTAINS   1500   20/1   21   *   22   20/1   1176   SF-5     SMOKE CURTAINS   1500   20/1   23   *   24   20/1   1176   SF-5     SMOKE DAMPERS   1500   20/1   25   *   26   50/3   3864   SF-3 STAIR PRESSURIZATION FAN     SMOKE DAMPERS   1500   20/1   29   * 30   * 3864   *     SPARE   0   20/1   29   * 30   * 3864   *     SPARE   0   20/1   29   * 30   * 3864   *     SPARE   0   20/1   29   * 30   * 3864   *     SHANK   35   36   * 3864   *     BLANK   37   * 38   BLANK     BLANK   37   * 38   BLANK     BLANK   41   *   42   BLANK     BLANK   41   *   42   BLANK     Phase A   16844 VA   NOTES:   Iine-line voltage     Dioad code:   ph. A   ph. B   ph. C   total   factor   Calculated load (va)     1. LIGHTS =   916   1264   1016   VA   3196   1.25   3995     2. RECEPT =   500   0   0   VA   500   1 + 0.5   500     3. HEATING   0   0   0   VA   0   1.00   0     4. KITCHEN   0   0   0   VA   0   1.00   0     4. KITCHEN   0   0   0   VA   0   1.00   0     5. EQUIP =   6200   5200   5000   VA   16400   1.00   16400     6. MOTORS   9228   10404   8904   VA   28536   *	1	LIGHTS - STAIR #1	806	20/1	5	*	6	20/1	1500	GENERATOR BLOCK HEATER	†
LIGHTS - FLRS 3,4,5	1	ELEV PITS & LTS (PIT & SHAFT)	500	20/1	7	*	8	20/1	1500	GENERATOR BATTERY CHARGER	₹
LIGHTS - FLRS 6,7,8	1	LIGHTS - BSMNT, FLR 1 & 2	220	20/1	9	*	10	20/1	500	FACP/VOICE EVAC	t
1   LIGHTS - FLRS 9, 10,11, 12, ROOF   300   20/1   15	1	LIGHTS - FLRS 3,4,5	210	20/1	11	*	12	20/1	1176	SP-1 (ELEV PIT)	†
S DOOR OPENERS	1	LIGHTS - FLRS 6,7,8	210	20/1	13	*	14	20/1	500	RECEPT - ELEV MACH RM	†
S   SMOKE CURTAINS   1500   20/1   19   20   20/1   500   STAIR #2 DAMPERS   5   SMOKE CURTAINS   1500   20/1   21   22   20/1   1176   SF-5   5   SMOKE CURTAINS   1500   20/1   23   24   20/1   25   5   26   50/3   3864   SF-3 STAIR PRESSURIZATION FAN   5   SMOKE DAMPERS   1500   20/1   27   28   3   3864   8   3864   8   3864   3864   3864   3864   3864   3864   3864   3864   3864   3864   3864   3864   3864   3864   3864   3864   3864   3864   3864   38	1	LIGHTS - FLRS 9,10,11,12,ROOF	300	20/1	15	*	16	20/1	500	GENERATOR REMOTE ANNUNC.	İ
SMOKE CURTAINS	5	DÓOR OPENERS	1500	20/1	17	*	18	20/1	500	STAIR #1 DAMPERS	1
SMOKE CURTAINS	5	SMOKE CURTAINS	1500	20/1	19	*	20	20/1	500	STAIR #2 DAMPERS	†
S   SMOKE DAMPERS   1500   20/1   25   *   26   50/3   3864   SF-3 STAIR PRESSURIZATION FAN   5 SMOKE DAMPERS   1500   20/1   27   *   28   *   3864   *	5	SMOKE CURTAINS	1500	20/1	21	*	22	20/1	1176	SF-5	†
SMOKE DAMPERS	5	SMOKE CURTAINS	1500	20/1	23	*	24	20/1	$\sim$	SPARE	ŧ
SPARE	5	SMOKE DAMPERS	1500	20/1	25	*	26	50/3	3864	SF-3 STAIR PRESSURIZATION FAN	1
AC/OAC-3	5	SMOKE DAMPERS	1500	20/1	27	*	28	*	3864	*	†
Section   1500   1500   SPARE	0	20/1	29	*	30	*	3864	*	Ť
BLANK   35	6	IAC/OAC-3	1500	30/2	31	*	32	50/3	3864	SF-4 STAIR PRESSURIZATION FAN	1
BLANK   37 * 38   BLANK   BL	6	*	1500	*	33	*	34	*	3864	*	Ť
BLANK		BLANK			35	*	36	*	3864	*	Ť
BLANK		BLANK			37	*	38			BLANK	Ť
Phase A         16844 VA         NOTES:         line-line voltage           Phase B         16868 VA         208           Phase C         14920 VA         largest motor (va)           Total Connected         48632 VA         0           load code:         ph. A         ph. B         ph. C         total factor         calculated load (va)           1. LIGHTS=         916         1264         1016 VA         3196         1.25         3995           2. RECEPT.=         500         0         0 VA         500         1 + 0.5         500           3. HEATING=         0         0         0 VA         0 1.00         0           4. KITCHEN=         0         0         5000 VA         16400         1.00         16400           5. EQUIP.=         6200         5200         5000 VA         16400         1.00         16400           6. MOTORS=         9228         10404         8904 VA         28536         *         28536		BLANK			39	*	40			BLANK	Ť
Phase B       16868 VA       208         Phase C       14920 VA       largest motor (va)         Total Connected       48632 VA       total factor       calculated load (va)         1. LIGHTS=       916       1264       1016       VA       3196       1.25       3995         2. RECEPT.=       500       0       0       VA       500       1+0.5       500         3. HEATING=       0       0       0       VA       0       1.00       0         4. KITCHEN=       0       0       0       VA       0       1.00       0         5. EQUIP.=       6200       5200       5000       VA       16400       1.00       16400         6. MOTORS=       9228       10404       8904       VA       28536       *       28536		BLANK			41	*	42			BLANK	Ť
Phase C         14920 VA         largest motor (va)           Total Connected         48632 VA         Dh. C         total factor         calculated load (va)           1. LIGHTS=         916         1264         1016         VA         3196         1.25         3995           2. RECEPT.=         500         0         0         VA         500         1 + 0.5         500           3. HEATING=         0         0         0         VA         0         1.00         0           4. KITCHEN=         0         0         0         VA         0         1.00         0           5. EQUIP.=         6200         5200         5000         VA         16400         1.00         16400           6. MOTORS=         9228         10404         8904         VA         28536         *         28536		Phase A	16844	VA		•	NOTES	:		line-line voltage	
Total Connected         48632 VA         O           load code:         ph. A         ph. B         ph. C         total factor         calculated load (va)           1. LIGHTS=         916 1264         1016 VA         3196 1.25         3995           2. RECEPT.=         500 0         0 VA         500 1 + 0.5         500           3. HEATING=         0 0 0 VA         0 1.00         0           4. KITCHEN=         0 0 0 VA         0 1.00         0           5. EQUIP.=         6200 5200         5000 VA         16400 1.00         16400           6. MOTORS=         9228 10404         8904 VA         28536         *         28536		Phase B	16868	VA						208	3
load code:         ph. A         ph. B         ph. C         total         factor         calculated load (va)           1. LIGHTS=         916         1264         1016         VA         3196         1.25         3995           2. RECEPT.=         500         0         0         VA         500         1 + 0.5         500           3. HEATING=         0         0         0         VA         0         1.00         0           4. KITCHEN=         0         0         0         VA         0         1.00         0           5. EQUIP.=         6200         5200         5000         VA         16400         1.00         16400           6. MOTORS=         9228         10404         8904         VA         28536         *         28536		Phase C	14920	VA						largest motor (va)	
1. LIGHTS=       916       1264       1016       VA       3196       1.25       3995         2. RECEPT.=       500       0       0 VA       500       1 + 0.5       500         3. HEATING=       0       0       0 VA       0 1.00       0         4. KITCHEN=       0       0       VA       0 1.00       0         5. EQUIP.=       6200       5200       5000       VA       16400       1.00       16400         6. MOTORS=       9228       10404       8904       VA       28536       *       28536		Total Connected	48632	VA						0	)
2. RECEPT.=       500       0       0       VA       500       1 + 0.5       500         3. HEATING=       0       0       0       VA       0       1.00       0         4. KITCHEN=       0       0       0       VA       0       1.00       0         5. EQUIP.=       6200       5200       5000       VA       16400       1.00       16400         6. MOTORS=       9228       10404       8904       VA       28536       *       28536		load code:	ph. A	ph. B		ph. C		total	factor	calculated load (va)	
3. HEATING=       0       0       0       VA       0       1.00       0         4. KITCHEN=       0       0       0       VA       0       1.00       0         5. EQUIP.=       6200       5200       5000       VA       16400       1.00       16400         6. MOTORS=       9228       10404       8904       VA       28536       *       28536		1. LIGHTS=	916	1264		1016	VA	3196	1.25	3995	5
4. KITCHEN=       0       0       0 VA       0       1.00       0         5. EQUIP.=       6200       5200       5000 VA       16400       1.00       16400         6. MOTORS=       9228       10404       8904 VA       28536       *       28536		2. RECEPT.=	500	0		0	VA	500	1 + 0.5	500	)
5. EQUIP.=       6200       5200       5000       VA       16400       1.00       16400         6. MOTORS=       9228       10404       8904       VA       28536       *       28536		3. HEATING=	0	0		0	VA	0	1.00	0	)
6. MOTORS= 9228 10404 8904 VA 28536 * 28536		4. KITCHEN=	0	0		0	VA	0	1.00	0	)
		5. EQUIP.=	6200	5200		5000	VA	16400	1.00	16400	)
7. MISC= 0 0 VA 0 1.00 0		6. MOTORS=	9228	10404		8904	VA	28536	*	28536	ì
		7. MISC=	0	0		0	VA	0	1.00	0	)

	panel		mountin	g		location	1		connected load amps	
	VP		SURFA	CE		CLASS	A VAUL	_T		19
	voltage		phase		b	us & ma	iin		calculated load amps	
	120/208V (SCCR: 42 KAIC)		3		100A			MLO		20
)	service	va	a/p	no.	abc	no.	a/p	va	service	
1	LIGHTS	1000	20/1	1	*	2	20/1	1200	RECEPTACLES	
1	LIGHTS - EGRESS	500	20/1	3	*	4	20/1	1200	RECEPT - SUMP PUMP SP-X	
5	SMOKE DAMPERS	500	20/1	5	*	6	30/2		IAC/OAC-X	
5	SMOKE DAMPERS	500	20/1	7	*	8	*		*	
3	EF-5	1920	30/1	9	*	10	20/1	0	SPARE	
	SPARE	0	20/1	11	*	12	20/1	0	SPARE	
	BLANK			13	*	14			BLANK	
	BLANK			15	*	16			BLANK	
	BLANK			17	*	18			BLANK	
	BLANK			19	*	20			BLANK	
	BLANK			21	*	22			BLANK	
	BLANK			23	*	24			BLANK	
				25	*	26				
				27	*	28				
				29	*	30				
				31	*	32				
				33	*	34				
				35	*	36				
				37	*	38				
				39	*	40				
				41	*	42				
	Phase A	2700	VA			NOTES:	<u> </u>		line-line voltage	
	Phase B	3620	VA						Ğ	20
	Phase C	500	VA						largest motor (va)	
	Total Connected	6820							3 (,	
	load code:	ph. A	ph. B		ph. C		total	factor	calculated load (va)	
	1. LIGHTS=	1000	•		, 0	VA	1500	1.25	` '	187
	2. RECEPT.=	1200			0			1 + 0.5		240
	3. HEATING=	0	0		0		0			
	4. KITCHEN=		0		0	VA	٥			
	5. EQUIP.=	500			500		1000		,	100
	6. MOTORS=	0	1920		0	VA	1920			192
	7. MISC=		0		0		0			
	(* 125% of the largest motor + 100%		_					TOTAL =	<u> </u>	719

	panel		mountin	g		location	)		connected load amps	
	HP1		SURFA	-		ELECT	. ROOM		395	j
	voltage		phase		bi	us & ma	in		calculated load amps	
	120/208V (SCCR: 42KAIC)		3		600A			MLO	419	<b>)</b>
<u> </u>	service	va	a/p	no.	abc	no.	a/p	va	service	ТС
1	LIGHTS - BLDG EXTERIOR	116	20/1	1	*	2	20/1	1500	RECEPT - 1ST FLR	2
1	LIGHTS - BSMNT, FLR 1 & 2	640	20/1	3	*	4	20/1	1500	RECEPT - 1ST FLR & SF-2	2
1	LIGHTS - FLR 1	485	20/1	5	*	6	20/1	1080	RECEPT - 1ST FLR	2
1	LIGHTS - FLRS 3,4,5	240	20/1	7	*	8	20/1	1500	REFRIGERATOR	4
1	LIGHTS - FLRS 6,7,8	240	20/1	9	*	10	20/1	500	RECEPT - KITCHEN	2
1	LIGHTS - FLRS 9,10,11,12,ROOF	320	20/1	11	*	12	20/1	900	DISPOSAL	4
1	LIGHTS - LANDSCAPING	0	20/1	13	*	14	20/1	~500	RECEDIT KITCHEH	<b>₩</b>
1	LIGHTS - ROOF (EXTERIOR)	145	20/1	15	*	16	20/1	1500	RECPT - BIKE CHARGING	2
5	TELECOM PANEL	500	20/1	17	*	18	20/1	<del></del>	RECEPTIONPLR	Z
5	TELECOM PANEL	500	20/1	19	*	20	20/1	500	SF-1 (x10)	6
5	TLELCOM PANEL	500	20/1	21	*	22	20/1	500	RECEPT - ELEV MACHINE RM	2
5	LANDSCAPE	500	20/1	23	*	24	20/1	1440	RECEPT - FLRS 2,3	2
5	IRRIGATION	500	20/1	25	*	26	20/1	1440	RECEPT - FLRS 4,5	2
1	LIGHTS - FLOOR 12	500	20/1	27	*	28	20/1	1440	RECEPT - FLRS 6,7	2
3	IA/OAC-1	1500	30/2	29	*	30	20/1	1440	RECEPT - FLRS 8,9	2
3	*	1500	*	31	*	32	20/1	1440	RECEPT - FLRS 10,11	2
3	IAC/OAC-2	1500	30/2	33	*	34	20/1	0	SPARE	
3	*	1500	*	35	*	36	20/1	0	SPARE	
7	PANEL HP2	20916	200/3	37	*	38	200/3	8000	PANEL HP3	7
7	*	20412	*	39	*	40	*	21600	*	7
7	*	20004	*	41	*	42	*	21600	*	7
	Phase A	38652	VA			NOTES	:		line-line voltage	
	Phase B	50977	VA						208	}
	Phase C	52349	VA						largest motor (va)	
	Total Connected	141978	VA						43200	)
	load code:	ph. A	ph. B		ph. C		total	factor	calculated load (va)	
	1. LIGHTS=	356	1525		805	VA	2686	1.25	3358	}
	2. RECEPT.=	4880	5440		5040	VA	15360	1 + 0.5	12680	)
	3. HEATING=	0	0		0	VA	0	1.00	0	)
	4. KITCHEN=	1500	0		900	VA	2400	1.00	2400	)
	5. EQUIP.=	1000	500		1000	VA	2500	1.00	2500	)
	6. MOTORS=	2000	1500		3000	VA	6500	*	17300	)
	7. MISC=	28916	42012		41604	VA	112532	1.00	112532	<u>,</u>

			MFIA P	ANEL S	SCHEDU	LE				
	panel		mountir	ng		location	1		connected load amps	
	HP2		SURFA	CE		ELECT. ROOM			170	0
	voltage		phase		b	us & ma	iin		calculated load amps	
	120/208V (SCCR: 42KAIC)		3		200A			MLO	170	0
С	service	va	a/p	no.	abc	no.	a/p	va	service	С
3	EH-1 STAIRWELL	1500	20/1	1	*	2	20/1	1500	RECEPT - BASEMENT, EF-4	2
3	EH-1 STAIRWELL	1500	20/1	3	*	4	20/1	1500	RECEPT- BASEMENT	2
6	TRASH COMPACTOR	2100	30/3	5	*	6	20/1	1500	B-1, B-2, B-3 GAS BOILERS	5
6	*	2100	*	7	*	8	20/1	1500	WH-1, WH-2 GAS WATER HTRS	5
6	*	2100	*	9	*	10	20/1	1176	RP-1	6
3	IHP/OHP & EF-6 (FIT. RM)	1768	30/2	11	*	12	30/3	828	SP-2 (BIKE STORGE)	6
3	*	1768	*	13	*	14	*	828	*	6
6	P-1 (5HP)	2912	50/2	15	*	16	*	828	*	6
6	*	2912	*	17	*	18	20/1	2088	P-3, P-4, P-5	6
6	P-2 (5HP)	2912	50/2	19	*	20	20/1	1500	EH-1 (LAUNDRY)	3
6	*	2912	*	21	*	22	20/1	500	EH-2 (RISER RM)	3
2	RECEPT - FITNESS ROOM	1500	20/1	23	*	24	20/1	1500	EH-1 (BIKE RM)	3
2	RECEPT - FITNESS ROOM	1500	20/1	25	*	26	20/1	1500	EH-1 (BIKE RM)	3
2	RECEPT - FITNESS ROOM	1500	20/1	27	*	28	30/3	2808	BOOSTER PUMP	6
2	RECEPT - FITNESS ROOM	1500	20/1	29	*	30	*	2808	*	6
2	RECEPT - FITNESS ROOM	1500	20/1	31	*	32	*	2808	*	6
6	RP-2	1176	20/1	33	*	34	20/2	1500	WH-3	3
<b>-</b>	SPARE	<b>~~</b>	20/1	35	*	36	*	1500	*	3
	SPARE	0	20/1	37	*	38	20/1	~~	SPARE	<del>~</del>
	SPARE	0	20/1	39	*	40	20/1	0	SPARE	
	SPARE	0	20/1	41	*	42	20/1	0	SPARE	
	Phase A	20916	VA			NOTES	:		line-line voltage	
	Phase B	20412	VA						208	8
	Phase C	20004	VA						largest motor (va)	
	Total Connected	61332	VA							
	load code:	ph. A	ph. B	<u> </u>	ph. C		total	factor	calculated load (va)	
	1. LIGHTS=	0	0		0	VA	0	1.25		0
	2. RECEPT.=	4500	3000		3000	VA	10500	1 + 0.5	10250	0
	3. HEATING=	6268	3500		4768	VA	14536	1.00	14536	6
	4. KITCHEN=	0	0		0	VA	О	1.00		0
	5. EQUIP.= 1500				1500	VA	3000	1.00	3000	0
	6. MOTORS=	8648	13912		10736	VA	33296	*	3329	6
	7. MISC=	0	0		0	VA	0	1.00		0
	(* 125% of the largest motor + 100%	of the h	i alance)		1			L TOTAL =	: 61082	2

					SCHEDU						
	panel		mountir	ng		locatio	n		connected load amps		
	HP3		SURFA	CE		ELECT	. ROOM			142	
	voltage		phase		b	us & ma	ain		calculated load amps		
	120/208V (SCCR: 42KAIC)		3		200A			MLO		142	
С	service	va	a/p	no.	abc	no.	a/p	va	service		
2	WASHER	1500	20/1	1	*	2	20/1	1500	WASHER		5
5	DRYER	4320		3	*	4	30/2	4320	DRYER		
5	*	4320	*	5	*	6	*	4320	*		4
5	WASHER	1500	20/1	7	*	8	20/1	1500	WASHER		į
5	DRYER	4320	30/2	9	*	10	30/2	4320	DRYER		į
5	*	4320	*	11	*	12	*	4320	*		į
5	WASHER	1500	20/1	13	*	14	20/1	500	DRYER BOOSTER FANS		Ę
5	DRYER	4320	30/2	15	*	16	20/1	0	SPARE		
5	*	4320	*	17	*	18	20/1	0	SPARE		
				19	*	20			BLANK		
	BLANK			21	*	22			BLANK		
	BLANK			23	*	24			BLANK		
	BLANK			25	*	26			BLANK		
	BLANK			27	*	28			BLANK		
	BLANK			29	*	30			BLANK		
	BLANK			31	*	32			BLANK		
	BLANK			33	*	34			BLANK		
	BLANK			35	*	36			BLANK		
	BLANK			37	*	38			BLANK		
	BLANK			39	*	40			BLANK		
	BLANK			41	*	42			BLANK		
	Phase A	8000	VA			NOTES	:		line-line voltage		
	Phase B	21600	VA							208	
	Phase C	21600	VA						largest motor (va)		
	Total Connected	51200	VA								
	load code:	ph. A	ph. B		ph. C		total	factor	calculated load (va)		
	1. LIGHTS=	, 0			0	VA	0	1.25	,	0	
	2. RECEPT.=	1500	l o		0	VA	1500	1 + 0.5		1500	
	3. HEATING=	0			0		0	1.00		0	
	4. KITCHEN=	0			0		0	1.00		0	
	5. EQUIP.=	6500	21600		21600		49700	1.00		49700	
	6. MOTORS=	0			0		0			0	
	7. MISC=				0					0	
_	(* 125% of the largest motor + 100%							TOTAL =		51200	_

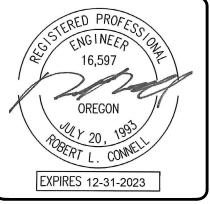

SCHEDULES OREGON

 $\approx$ 

PARK APARTMENTS
RYSTADT
2057 SW PARK AVE. SUMMARY

LOAD CTRICAL

Consulting Engineers 2007 S.E. Ash St. Portland, OR 97214 PHN: (503) 234-0548 FAX: (503) 234-0677 WWW.MFIA-ENG.COM

SHEET

E1.12

		MECHAN	NICAL	EQU	IPMENT :	SCHEDU	ILE		
NO.	EQUIPMENT NAME	HP/KW	VOLTS	PH	AMPS	CONDUIT	WIRE	GND	CIRCUIT
EF-1	EXHAUST FAN NO.1	11.0W	120	1		1/2"	#12	#12	SEE TYP. UNIT PLANS
EF-2	EXHAUST FAN NO.2	11.0W	120	1		1/2"	#12	#12	
EF-3	EXHAUST FAN NO.3	11.0W	120	1		1/2"	#12	#12	HP2-27
EF-4	EXHAUST FAN NO.4	11.0W	120	1		1/2"	#12	#12	HP2-33
EF-5	EXHAUST FAN NO.5	1HP	120	1		1/2"	#12	#12	VP-9
EF-6	EXHAUST FAN NO.6	16W	120	1		1/2"	#12	#12	SEE NOTE "E" BELOW
EH-1	WALL HEATER NO.1	1.5KW	208	1		1/2"	#12	#12	SEE POWER PLANS
EH-2	WALL HEATER NO.2	500W	120	1		1/2"	#12	#12	SEE POWER PLANS
EH-3	WALL HEATER NO.3	4.0KW	208	1		1/2"	#12	#12	SEE POWER PLANS
	SPLIT SYST NO.1 (BOILER RM)			-		-,-	<i>"</i>	<b>"</b>	INTERCONNECT W/ OA
	SPLIT SYST NO.1 (OUTDOOR)		208	1	18.0 MCA	1/2"	#10	#10	HP1-29,31
	SPLIT SYST NO.2 (IT RM)			-			<b>"</b> • • • • • • • • • • • • • • • • • • •	<u> </u>	INTERCONNECT W/ OA
	SPLIT SYST NO.2 (OUTDOOR)		208	1	18.0 MCA	1/2'	#10	#10	HP1-33,35
	SPLIT SYST NO.3 (RISER RM)			-			<b>"</b> • • • • • • • • • • • • • • • • • • •	<u> </u>	INTERCONNECT W/ OA
	SPLIT SYST NO.3 (OUTDOOR)		208	1	18.0 MCA	1/2'	#10	#10	EP2-31,33
	SPLIT SYST NO.3 (CLASS A VAU	T)		•	1010 111071	','-	,,,,	<i>"</i> ,	INTERCONNECT W/ OA
	SPLIT SYST NO.X (OUTDOOR)	/	208	1	12.0 MCA	1/2'	#12	#12	VP-6,8
	SPLIT SYST NO.1 (FITNESS RM)			•	12.0 11.07	1,72	<i>#</i> · <b>-</b>	<i>,,-</i>	INTERCONNECT W/ OH
	SPLIT SYST NO.1 (OUTDOOR)		208	1	17.0 MCA	1/2'	#10	#10	HP2-11,13
B-1	BOILER NO.1 (GAS)		120	1	.,,,,,,,,,,,,,,,,,,,,,,,,,,,,,,,,,,,,,,	1/2"	#12	#12	HP2-6 (PC)
	BOILER NO.2 (GAS)		120	1		1/2"	#12	#12	HP2-6 (PC)
	BOILER NO.3 (GAS)		120	1		1/2"	#12	#12	HP2-6 (PC)
	BOOSTER PUMP NO.1	(3) 2HP	208	3		1/2"	#12 _#10	#10	HP2-28,30,32
<b>~~~~</b> P−1	PUMP NO. 1	5HP	208	~~~~~~~~~~~~~~~~~~~~~~~~~~~~~~~~~~~~~~	~~~~	3/4"	#6	#10	HP2-35,37
P-2	PUMP NO. 2	5HP	208	1		3/4"	# [©] #6	#10 #10	HP2-36,38
	POMP NO. 3	1/4HP	<del>~120~</del>	<u>_</u>	·····	1/2	#12···	<del></del>	HPZ=18 (PC)
P-4	PUMP NO. 4	1/4HP	120	1		1/2"	#12	#12 #12	HP2-18 (PC)
	PUMP NO. 5	1/4HP	120	1		1/2"	#12	#12 #12	HP2-18 (PC)
	RECIRC PUMP NO.1	1/2HP	120	1		1/2"	#12 _#12	#12	HP2-10
$\sim\sim$	RECIRC PUMP NO.2	1/2HP	120	~ <del>`</del>	<b>~~~~</b>	1/2"	#12	#12	HP2-33
$\overline{}$	SUPPLY FAN NO.2	13W	120	سئِب	·····	1/2"	#12	#12	SEE E3.01
	SUPPLY FAN NO.3	10HP	208	3		1"	#12	#12 #10	EP2-26,28,30
	SUPPLY FAN NO.4	10HP	208	3		1"	#6 #6	#10 #10	EP2-32,34,36
$\sim\sim$	SUPPLY FAN NO.5	1/4HP	120	~~~~	<b>~~~~</b>	1/2"	$\sim\sim\sim$	$\sim\sim$	EP2-22
	SUMP PUMP NO.1	1/2HP	120	~ <del>\</del>	·····	1/2"	12	#12 	EP2-12
	SUMP PUMP NO.2	•	208	3		<u> </u>	#12 #10	#12 #10	HP2-12,14,16
		2x 3/4HP				1/2"	#10	#10	<del>-  </del>
	WATER HEATER NO.1 (GAS)		120	1		1/2"	#12	#12	HP2-20 (PC)
WH-2	WATER HEATER NO.2 (GAS) WATER HEATER NO.3	<b>~~~~</b>	120 208	~~~	<b>~~~~</b>	1/2"	#12 ************************************	#12 ************************************	HP2-20 (PC)

### GENERAL EQUIPMENT NOTES:


- A. CONTRACTOR/DESIGNER SHALL VERIFY ALL MECHANICAL EQUIPMENT CONNECTION LOAD REQUIREMENTS WITH THE MECHANICAL EQUIPMENT PROVIDER PRIOR TO ROUGH IN.
- B. MECHANICAL EQUIPMENT SIZES SHOWN IN THE MECHANICAL SCHEDULE ABOVE ARE FOR REFERENCE ONLY AND MAY NOT REFLECT THE ACTUAL EQUIPMENT TO BE INSTALLED.
- C. INDOOR & OUTDOOR COMPONENTS OF THE MINI-SPLIT SYSTEMS ARE INTERCONNECTED. CONSULT WITH AND COORDINATE THE ELECTRICAL REQUIREMENTS AND EXACT LOCATIONS WITH THE HVAC EQUIPMENT INSTALLER PRIOR TO ROUGH IN.
- D. REFER TO TYPICAL UNIT PLAN LOAD CENTER SCHEDULES ON THIS SHEET FOR CIRCUITING INFORMATION.
- E. EXHAUST FAN EF-6 TO BE INTERCONNECTED WITH IHP/OHP-1 SPLIT SYSTEM. CONSULT MECHANICAL EQUIPMENT INSTALLER FOR ADDITIONAL INFORMATION.

		SW Par	k Ave. Apartr	nents				
Total Building Loads	Elect	rical Service L	oad - Main D	istribution (MI	OP)			
LOAD:	LIGHTS	RECEPT	HEAT	KITCHEN	EQUIP	MOTORS	MISC	LARGEST MOTOR
House Loads	3,358	23,680	14,536	2,400	55,200	50,596		
Residential Loads							407,000	
Generator Loads							156000	
SUBTOTAL	3,358	23,680	14,536	2,400	55,200	50,596	563,000	
X-FACTOR	1	1 + .5	1	1	1	1	1	0
CODE LOAD:	4,198	16,840	14,536	1,560	55,200	50,596	563,000	
CONN LOAD:	713	KVA						
VOLTS:	208	3ph						
TOTAL CALC:	706	KVA						
CALC AMPS:	1,960	AMPS						4/15/202


					Ave. Apartm				
	QTY		AREA	LTG	SM		MICRO/HOOD	MOTORS	LARGEST OF
UNIT TYPE:	PER FLOOR	TOTAL	(SF)	RECEPT	APPL	(NO OVEN)	(CONNECTED)	(CONNECTED)	AC/HEATING (CONNECTED)
	Studio			(3VA / SF)	(1500VA X 2)	(CONNECTED)			
Level 1	2	2	325	975	3000	8000	1700	0	3000
Level 2	8	8	325	975	3000	8000	1700	0	3000
Level 3	9	9	325	975	3000	8000	1700	0	3000
Level 4	9	9	325	975	3000	8000	1700	0	3000
Level 5	9	9	325	975	3000	8000	1700	О	3000
Level 6	9	9	325	975	3000	8000	1700	0	3000
Level 7	9	9	325	975	3000	8000	1700	О	3000
Level 8	9	9	325	975	3000	8000	1700	0	3000
Level 9	9	9	325	975	3000	8000	1700	o	3000
Level 10	9	9	325	975	3000	8000	1700	0	3000
Level 11	9	9	325	975	3000	8000	1700	0	3000
Level 12	9	9	325	975	3000	8000	1700	0	3000
TOTALS:	100	100	32500	97500	300000	800000	170000	0	300000
	VOLTS: TOTAL CONNECTED: DEMAND FACTOR: TOTAL CALCULATED: CALCULATED AMPS:	208 1770 0.23 407 1131	3ph KVA Based on T KVA AMPS	otal Number of F	Residential Units	= 63 & Over (See	e N.E.C. Article:	220.84)	

Connected amount of 8000w is the minimum connected load per NEC 220.55 for full diversity.


NOTE: Actual cooktop load is 3000w.

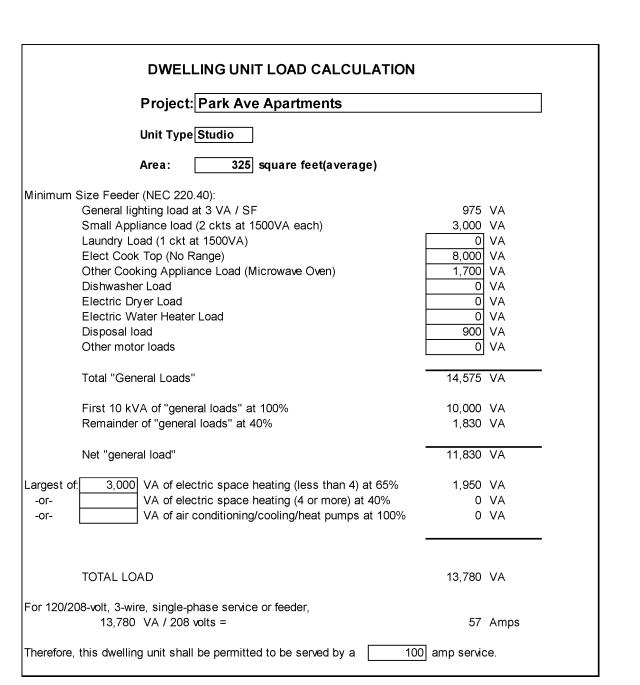

MFIA CIRCUIT DIRECTORY										
Loadcenter Name	mounting				location					
LC-STUDIO (TYPICAL)	RECESS			SED						
voltage	phase	bus & ma			in					
120/208	1		100A MLO		(SCCR: 22K)					
service	a/p	no.	L1	L2	no.	a/p	service			
LIGHTS-KITCHEN/LIVING	20/1(A)	1	*		2	20/1(A)	APPLIANCE CIRCUIT			
LTS & RECEPT - BATH	20/1	3		*	4	20/1(A)	APPLIANCE CIRCUIT			
LTS & RECEPT - BEDROOM	20/1(A)	5	*		6	20/1	REFRIGERATOR			
RECEPT - LIVING (OPTIONAL)	20/1(A)	7		*	8	20/1	MICRO/HOOD			
SMART PANEL	20/1	9	*		10	30/2	2-BURNER COOKTOP			
AC PORT (OPTIONAL)	20/1	11		*	12	*	*			
HEAT	20/2	13	*		14	20/1	DISPOSAL (OPTIONAL)			
*	*	15		*	16	20/1	SPARE			
SPARE	20/1	17	*		18	20/1	SPARE			
BLANK		19		*	20		BLANK			
BLANK		21	*		22		BLANK			
BLANK		23		*	24		BLANK			
BLANK		25	*		26		BLANK			
BLANK		27		*	28		BLANK			
BLANK		29	*		30		BLANK			
NOTES: 1. (A) DENOTES: ARC-FAULT INT 2. LOADS FOR THIS PANEL ARE 3. BREAKER & WIRE SHALL BE	INDICATE	D ON T	THE '	"DW	ELLING	UNIT LO				

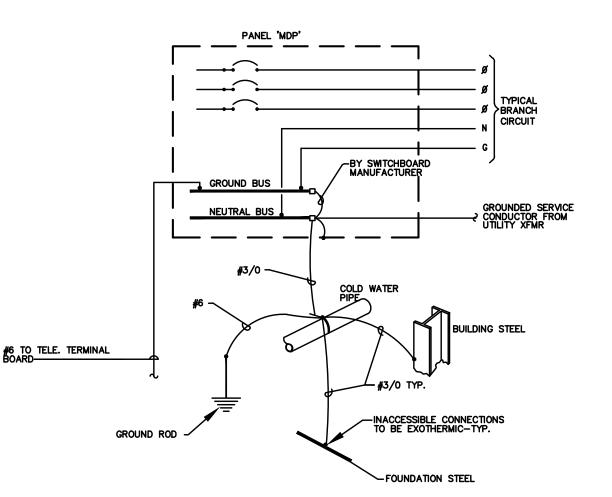

1 GROUNDING/BONDING DIAGRAM
E1.12 208Y/120V, 3ø, 4 WIRE

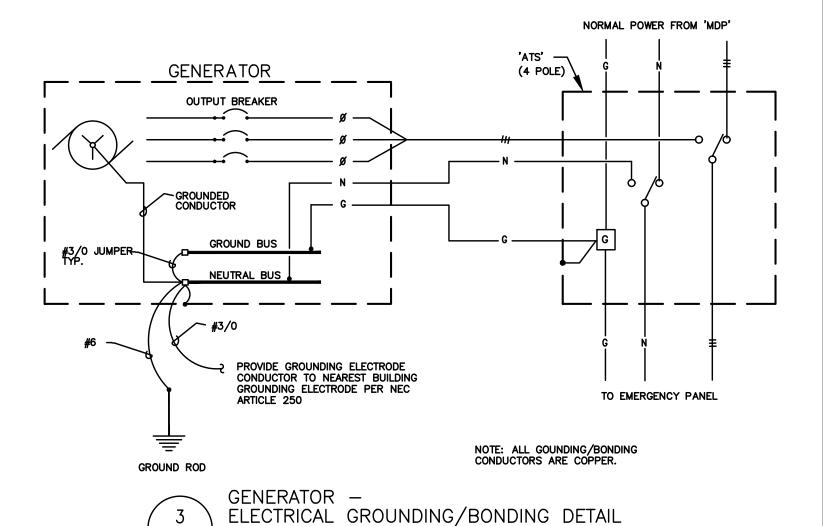

E1.12 NO SCALE

Consulting Engineers 2007 S.E. Ash St. Portland, OR 97214 PHN: (503) 234-0548 FAX: (503) 234-0677

www.mfia-eng.com

EXPIRES 12-31-2023

SHEET


ARTMENT


ARK RYS


VE.

2057

AIL

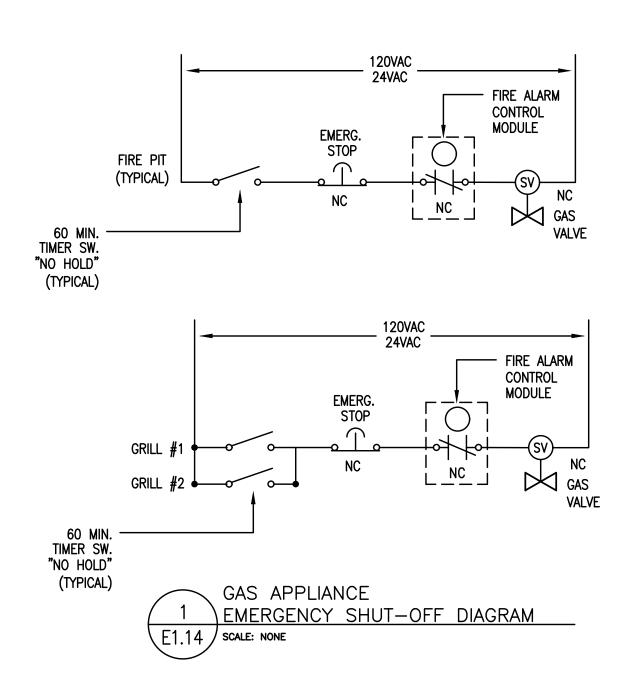


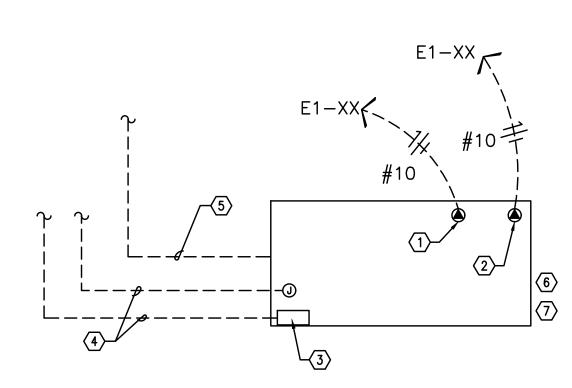


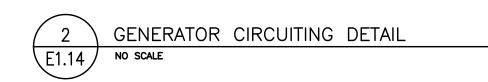


#### NOTES:

- 1. 120V GENERATOR BLOCK HEATER. SEE PANEL E1.
- 2. 120V GENERATOR BATTERY CHARGER. SEE PANEL E1.
- 3. GENERATOR OUTPUT BREAKER AND CONTROL SECTION. SEE PANEL E1.
- 4. POWER AND CONTROL TO TRANSFER SWITCH AND REMOTE ANNUNCIATOR. SEE ONE—LINE DIAGRAM ON SHEET E1.10.
- 5. TO AUTOMATIC TRANSFER SWITCH. SEE E1.10.
- 6. DIESEL GENERATOR TO BE PROVIDED WITH DOUBLE—WALL FUEL TANK AND SPILL CONTAINMENT PER CITY OF PORTLAND REQUIREMENTS.
- 7. DIESEL GENERATOR TANK SHALL DOUBLE WALLED AND BE EQUIPPED WITH OVERFILL PROTECTION (AUTO SHUTOFF), 5 GALLON INFILL SPILL BUCKET WITH DRAIN BACK, 12FT ABOVE GRADE TANK FUME VENTING AND ONSITE PRESSURE TESTING PER CITY REQUIREMENTS.

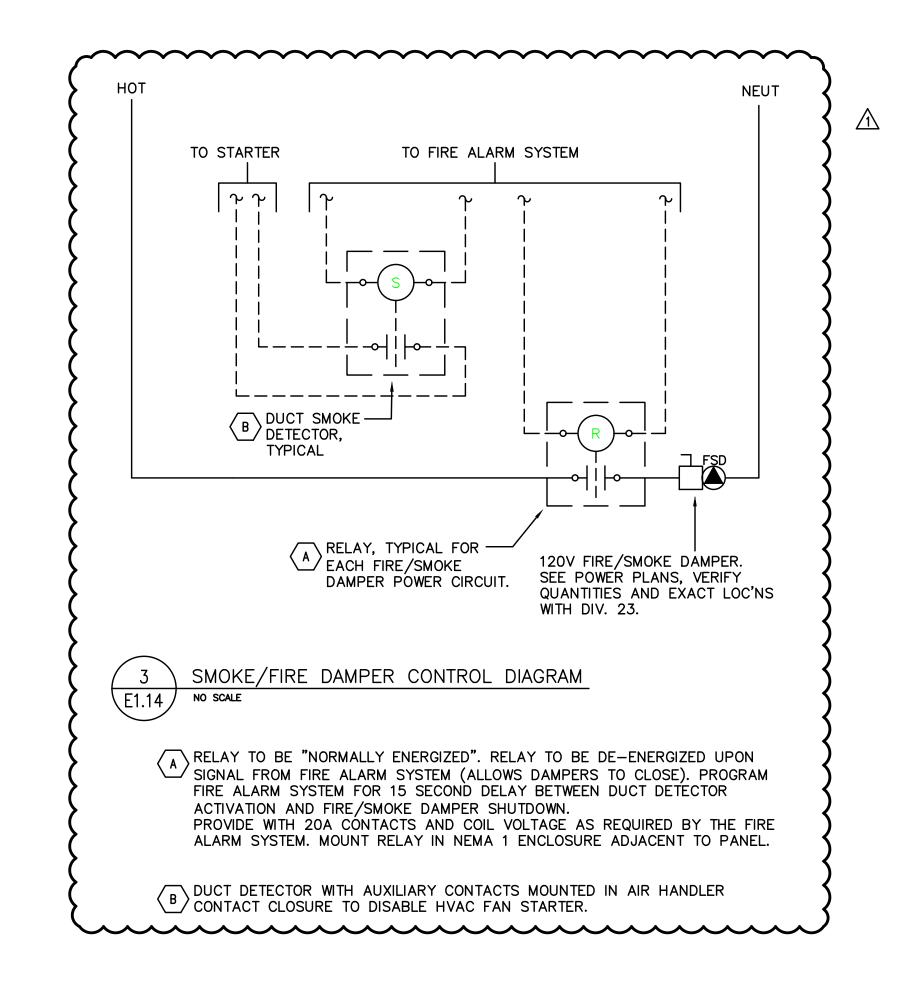

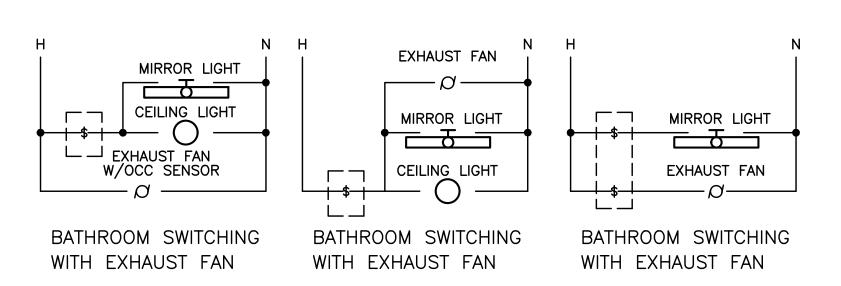



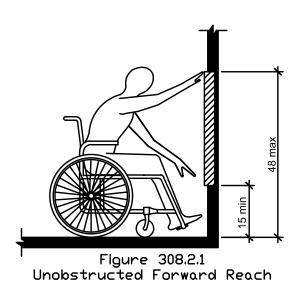



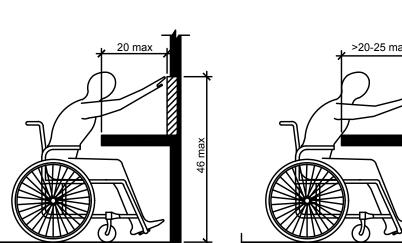


Figure 308.2.2 Obstructed High Forward Reach



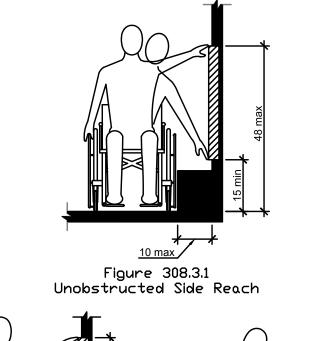

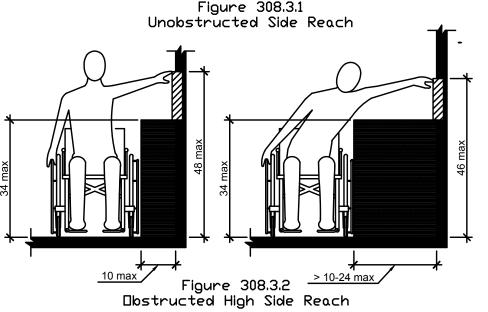

#### 308.2 Forward Reach.

308.2.1 Unobstructed. Where a forward reach is unobstructed, the high forward reach be 48" maximum and the low forward reach shall be 15" minimum above the f ground.

308.2.2 Obstructed High Reach. Where a high forward reach is over an obstruction, to clear floor or ground space shall extend beneath the element for a distance not thank the required reach depth over the obstruction. The high forward reach shall are maximum where the reach depth is 20" maximum. Where the reach depth is 20", the high forward reach shall be 44" maximum and the reach depth shall be maximum.

#### 308.3 Side Reach.

308.3.1 Unobstructed. Where a clear floor or ground space allows a parallel approa an element and the side reach is unobstructed, the high side reach shall be 48 maximum and the low side reach shall be 15" minimum above the floor or ground. Exception: Existing elements shall be permitted at 54" maximum above the floor or ground.

308.3.2 Obstructed High Reach. Where a clear floor or ground space allows a paralle approach to an object and the high side reach is over an obstruction, the height the obstruction shall be 34" maximum and the depth of the obstruction shall 2 maximum. The high side reach shall be 48" maximum for a reach depth of 10" maximum. Where the reach depth exceeds 10", the high side reach shall be 40 maximum for a reach depth of 24" maximum.



/E. OREGON

ARTMENT

ARK

2057 SW PARK AVE URE SCHEDULE &

ORTLAND


F X


M FI INC.

Consulting Engineers 2007 S.E. Ash St. Portland, OR 97214 PHN: (503) 234-0548 FAX: (503) 234-0677 WWW.MFIA-ENG.COM

SHEET

E1.14

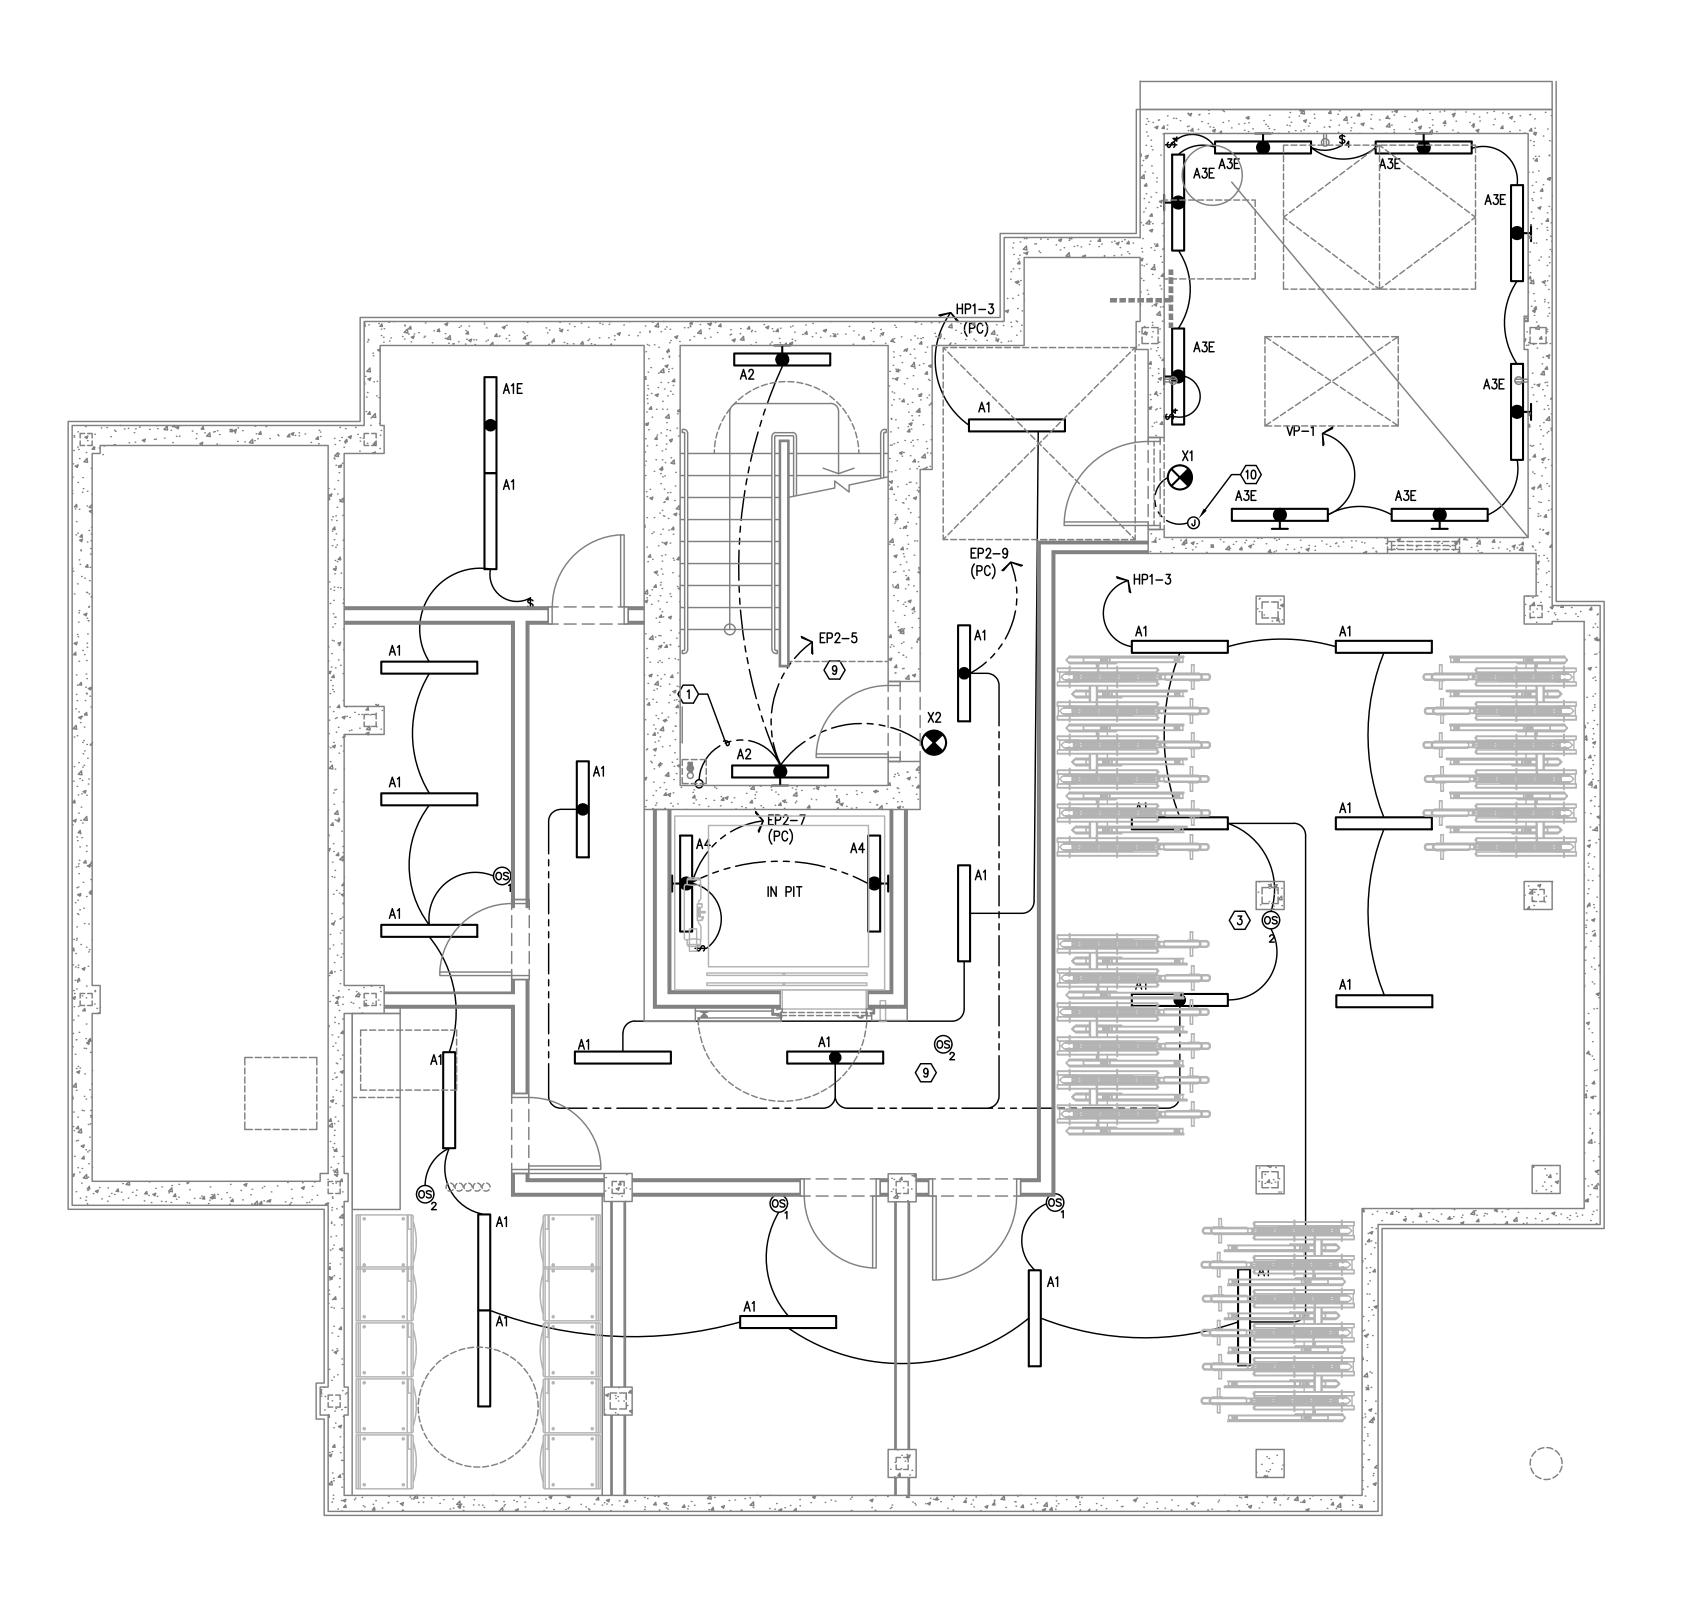

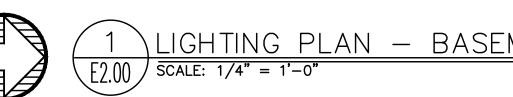



- A. ELECTRICAL DRAWINGS ARE DIAGRAMMATICAL AND MAY NOT ACCURATELY REFLECT ACTUAL CONSTRUCTION CONDITIONS. THE ELECTRICAL CONTRACTOR SHALL BE RESPONSIBLE FOR COORDINATING THE INSTALLATION OF ALL ELECTRICAL EQUIPMENT, WITH ALL TRADES PRIOR TO AND DURING CONSTRUCTION.
- B. THE ELECTRICAL CONTRACTOR SHALL REFER TO THE ARCHITECTURAL & INTERIOR DESIGN DRAWINGS FOR EXACT LOCATIONS, MOUNTING HEIGHTS AND FINISHES OF DEVICES AND FIXTURES.
- C. REFER TO ARCHITECTURAL INTERIOR ELEVATION PLANS FOR EXACT LOCATIONS OF FIXTURES AND
- D. REFER TO SHEET E1.21 FOR LIGHT FIXTURE SCHEDULE.
- E. REFER TO AVAILABLE ARCHITECTURAL AND/OR INTERIOR DESIGN DOCUMENTS & DRAWINGS FOR ADDITIONAL INFORMATION.
- F. OCCUPANCY SENSORS SHALL BE FIELD ADJUSTED TO ENSURE PROPER COVERAGE AND
- G. PROVIDE DIGITAL LIGHTING CONTROLS FOR EACH ROOM/SPACE, CONSISTING OF MULTI-BUTTON SWITCH(ES), OCC SENSORS, POWER PACKS, DAYLIGHT SENSORS, DIMMERS, INTERCONNECTING WIRING, ETC.
- H. CORRIDOR LIGHTING TO BE CONSTANT "ON" AND PROVIDED WITH LOCAL MANUAL OVERRIDE SWITCHES FOR MAINTENANCE. REFER TO SHEET E1.22 FOR SWITCH WIRING DIAGRAMS.
- ALL EGRESS FIXTURES SHALL BE WIRED SUCH THAT IN THE EVENT OF A POWER FAILURE, ALL LIGHTS WILL AUTOMATICALLY RETURN TO FULL POWER. REFER TO SWITCHING DETAILS ON SHEET E1.22.
- J. REFER TO SHEET E1.23 FOR LIGHTING CONTROL DIAGRAMS AND DESIGN INTENT. VERIFY LIGHTING CONTROLLABILITY WITH ARCHITECT AND/OR OWNER'S REPRESENTATIVE TO DETERMINE EXACT NEEDS FOR ALL PUBLIC/COMMON AREAS SUCH AS LOBBIES, OFFICES, LOUNGE AREAS, ETC., PRIOR TO THE START OF ANY WORK.
- K. THERE SHALL BE NO SURFACE MOUNTED FIXTURES OR PATHWAYS (CONDUIT, ETC.) IN ANY PUBLICLY ACCESSIBLE SPACES, INCLUDING STAIRWELLS AND EXIT PASSAGEWAYS WITHOUT PRIOR APPROVAL BY OWNER AND ARCHITECT. ROUTE ALL PATHWAYS WITHIN STUD CAVITIES OR ABOVE FINISHED CEILINGS.

### KEYED NOTES:

- 1. CONTINUE CIRCUIT UP THROUGH THE STAIRWELL.
- EXTERIOR BUILDING LIGHTS TO BE CONTROLLED VIA INTEGRAL AND/OR REMOTE PHOTOCELL FOR DUSK-TILL-DAWN OPERATION. REFER TO LIGHT FIXTURE SCHEDULE ON SHEET E1.21 FOR ADDITIONAL INFORMATION.
- 3. LIGHT FIXTURES IN THIS SPACE CONTROLLED BY CEILING MOUNT OCCUPANCY SENSOR.
- 4. PROVIDE PHOTOCELL FOR DAY-LIGHT REDUCTION OF LIGHT LEVELS.
- 5. CONTRACTOR TO COORDINATE WITH LANDSCAPE LIGHTING INSTALLER AND PROVIDE ROUGH-IN AND POWER CONNECTION(S) AS REQUIRED.
- 6. REFER TO SHEET E1.12 FOR TYPICAL DWELLING UNIT LOAD CENTER SCHEDULE FOR CIRCUITING INFORMATION.
- 7. REFER TO THE E3 SERIES SHEETS FOR TYPICAL DWELLING UNIT POWER DEVICE LAYOUT.
- 8. CORRIDOR LIGHTING CIRCUITS FOR THE UPPER FLOORS ARE AS FOLLOWS:

 $\overline{\text{FLOORS 3, 4, 5}} = EP2-11$ FLOORS 3, 4, 5 = HP1-7FLOORS 6, 7, 8 = HP1-9FLOORS 6, 7, 8 = EP2-13FLOORS 9, 10, 11, FLOORS 9, 10, 11, 12 & ROOF = HP1-11 12 & ROOF = EP2-15

- CORRIDOR AND STAIRWELL LIGHT FIXTURES TO BE CONTROLLED SUCH THAT THE FIXTURES DIM BY 50% DURING PERIODS OF LOW ACTIVITY. UPON DETECTION, LIGHTS SHALL RETURN TO 100% AND REMAIN AT FULL OUTPUT FOR A MINIMUM OF 30 MINUTES BEFORE RETURNING TO THE DIMMED STATE. FIXTURES ON EMERGENCY POWER CIRCUITS SHALL REMAIN 'ON' 24/7.
- 10. STROBE LIGHTS @ 24" AFF (BELOW SMOKE LING), AROUND PERIMETER FOR EGRESS. REFER TO 'T' SERIES SHEETS FOR MORE INFO. CIRCUIT TO PANEL 'VP'. SEE PANEL SCHEDULE ON SHEET E1.12.



Date: 04-08-Proj No: 1010 Drawn By: DMT Chkd By: RLC DSGN By: DMT

20

 $\triangleleft$ 

ட

**LIGHTIN** 



Consulting Engineers 2007 S.E. Ash St. Portland, OR 97214 PHN: (503) 234-0548 FAX: (503) 234-0677 WWW.MFIA-ENG.COM


SHEET

OF ***

LIGHTING PLAN - BASEMENT LEVEL





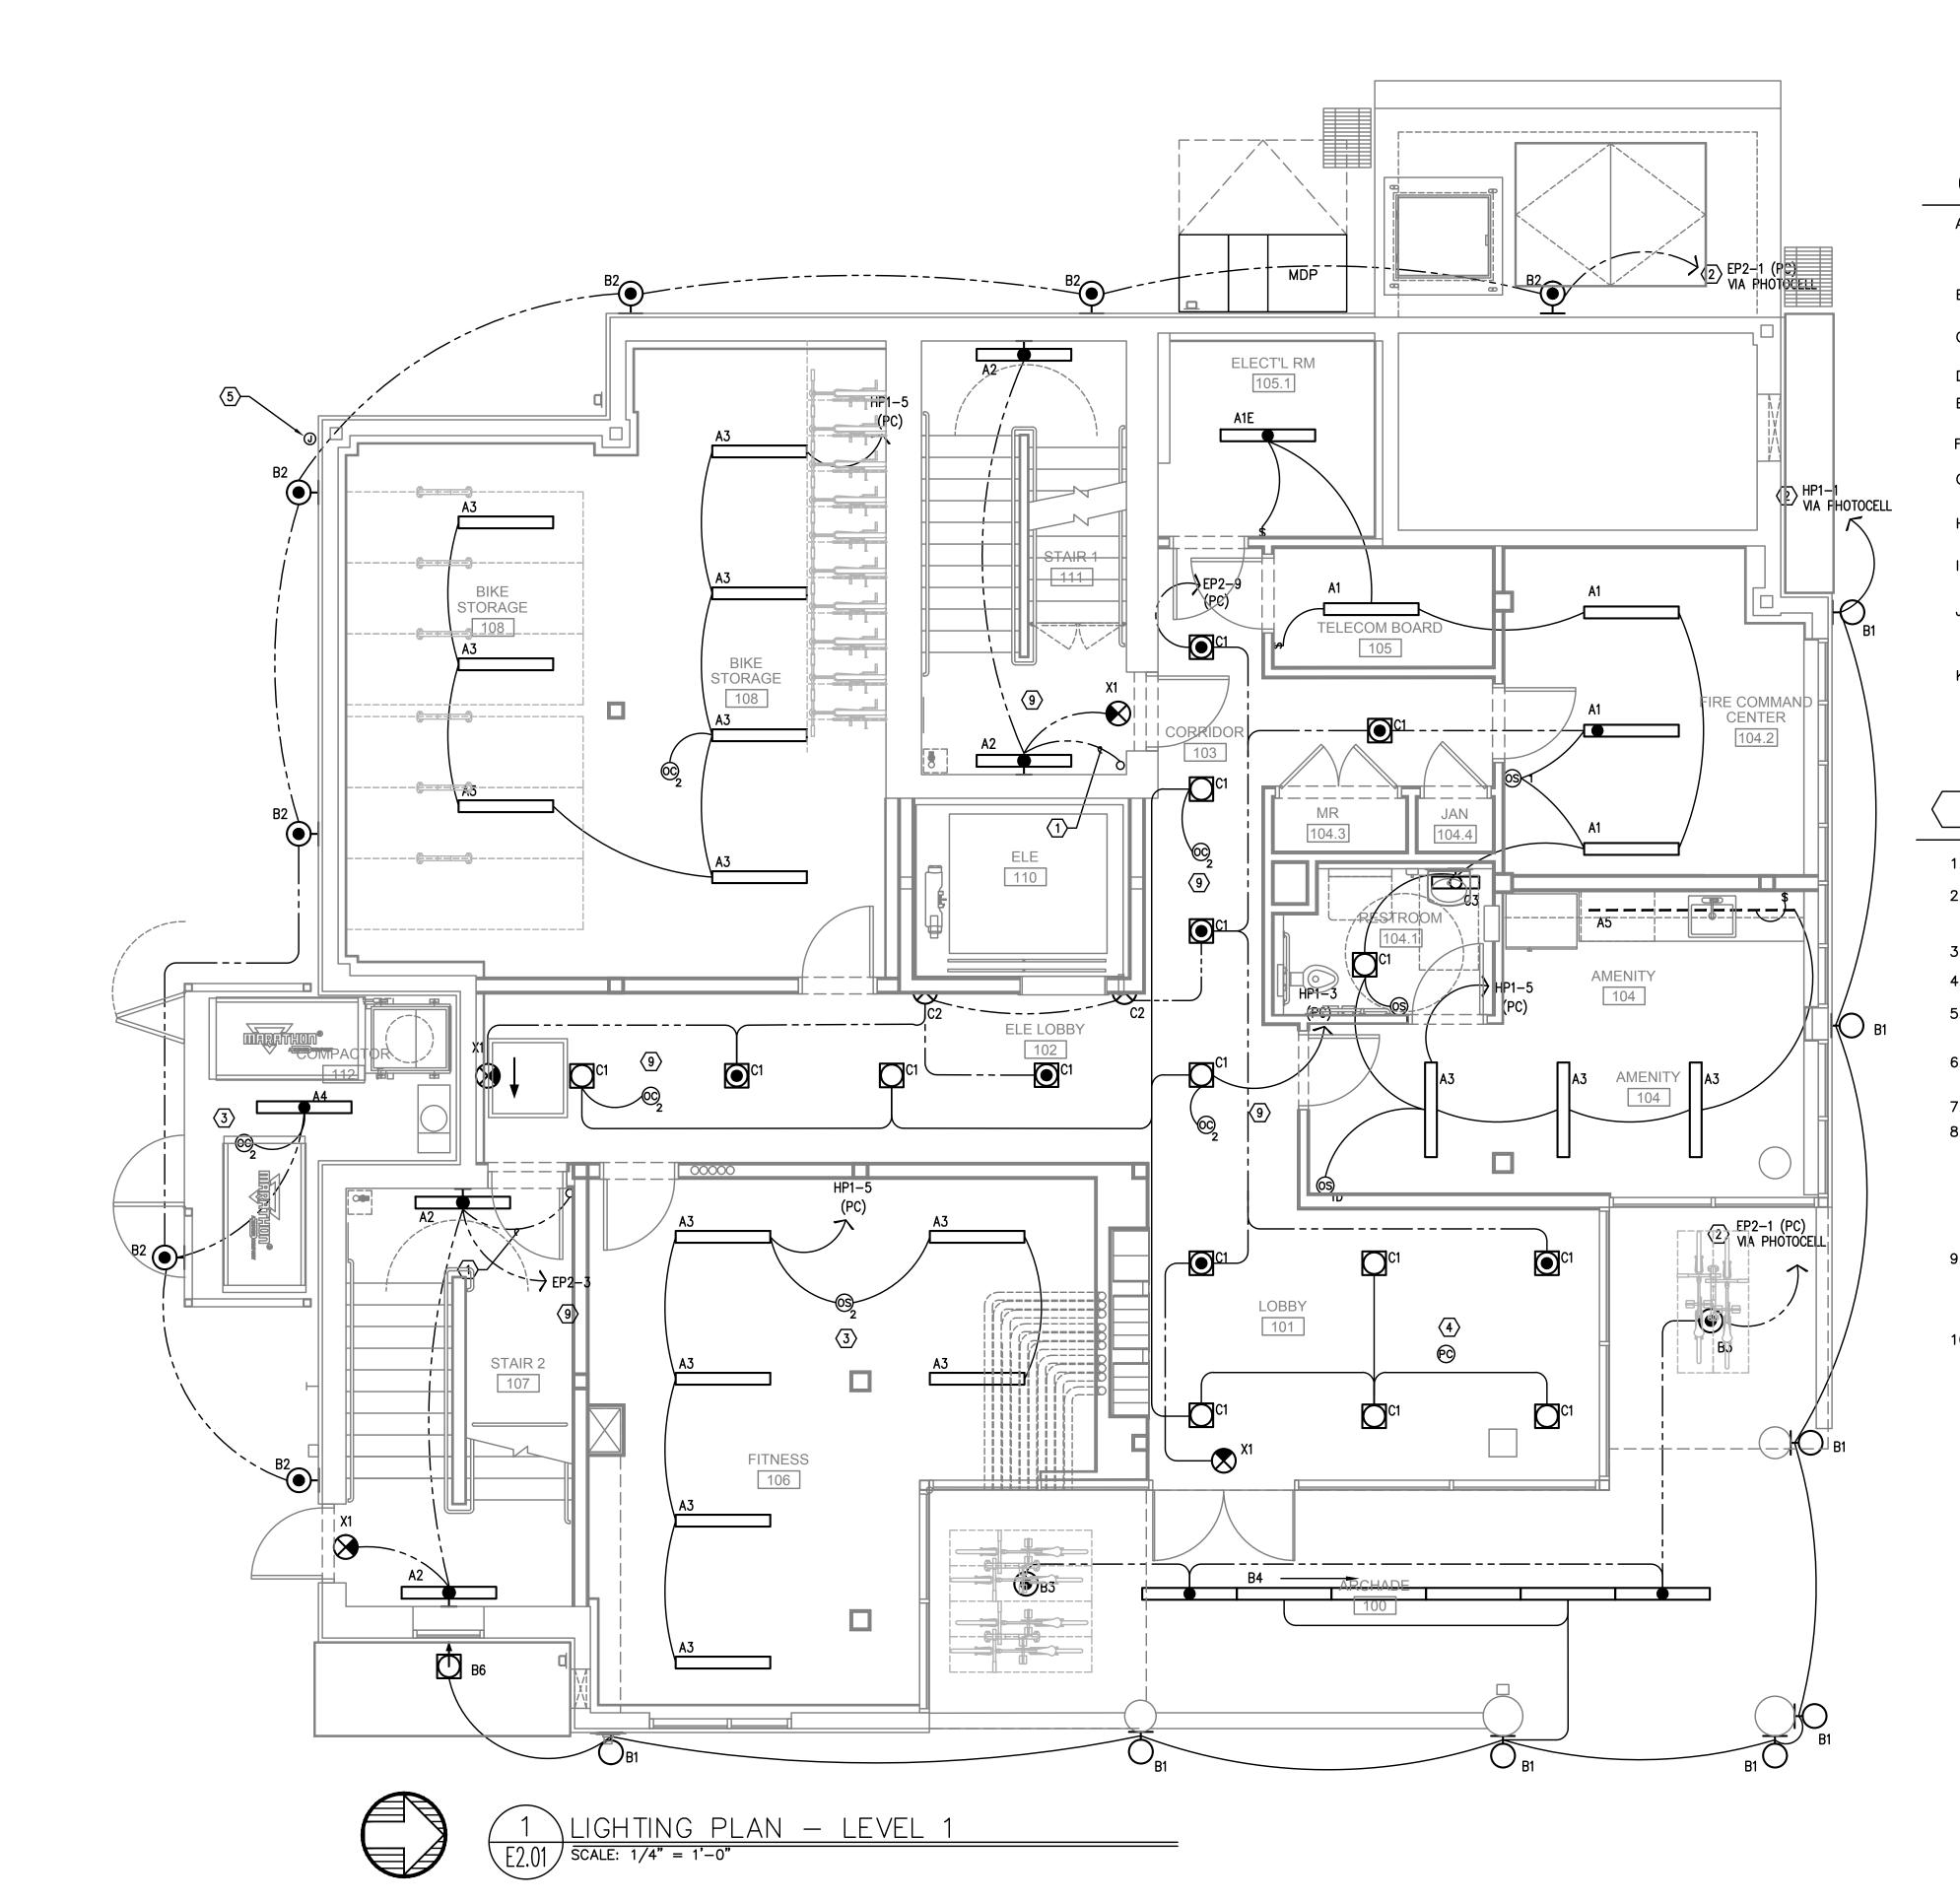

- A. ELECTRICAL DRAWINGS ARE DIAGRAMMATICAL AND MAY NOT ACCURATELY REFLECT ACTUAL CONSTRUCTION CONDITIONS. THE ELECTRICAL CONTRACTOR SHALL BE RESPONSIBLE FOR COORDINATING THE INSTALLATION OF ALL ELECTRICAL EQUIPMENT, WITH ALL TRADES PRIOR TO AND DURING CONSTRUCTION.
- B. THE ELECTRICAL CONTRACTOR SHALL REFER TO THE ARCHITECTURAL & INTERIOR DESIGN DRAWINGS FOR EXACT LOCATIONS, MOUNTING HEIGHTS AND FINISHES OF DEVICES AND FIXTURES.
- C. REFER TO ARCHITECTURAL INTERIOR ELEVATION PLANS FOR EXACT LOCATIONS OF FIXTURES AND
- D. REFER TO SHEET E1.21 FOR LIGHT FIXTURE SCHEDULE.
- E. REFER TO AVAILABLE ARCHITECTURAL AND/OR INTERIOR DESIGN DOCUMENTS & DRAWINGS FOR ADDITIONAL INFORMATION.
- F. OCCUPANCY SENSORS SHALL BE FIELD ADJUSTED TO ENSURE PROPER COVERAGE AND
- G. PROVIDE DIGITAL LIGHTING CONTROLS FOR EACH ROOM/SPACE, CONSISTING OF MULTI-BUTTON SWITCH(ES), OCC SENSORS, POWER PACKS, DAYLIGHT SENSORS, DIMMERS, INTERCONNECTING WIRING, ETC.
- H. CORRIDOR LIGHTING TO BE CONSTANT "ON" AND PROVIDED WITH LOCAL MANUAL OVERRIDE SWITCHES FOR MAINTENANCE. REFER TO SHEET E1.22 FOR SWITCH WIRING DIAGRAMS.
- ALL EGRESS FIXTURES SHALL BE WIRED SUCH THAT IN THE EVENT OF A POWER FAILURE, ALL LIGHTS WILL AUTOMATICALLY RETURN TO FULL POWER. REFER TO SWITCHING DETAILS ON SHEET E1.22.
- REFER TO SHEET E1.23 FOR LIGHTING CONTROL DIAGRAMS AND DESIGN INTENT. VERIFY LIGHTING CONTROLLABILITY WITH ARCHITECT AND/OR OWNER'S REPRESENTATIVE TO DETERMINE EXACT NEEDS FOR ALL PUBLIC/COMMON AREAS SUCH AS LOBBIES, OFFICES, LOUNGE AREAS, ETC., PRIOR TO THE START OF ANY WORK.
- K. THERE SHALL BE NO SURFACE MOUNTED FIXTURES OR PATHWAYS (CONDUIT, ETC.) IN ANY PUBLICLY ACCESSIBLE SPACES, INCLUDING STAIRWELLS AND EXIT PASSAGEWAYS WITHOUT PRIOR APPROVAL BY OWNER AND ARCHITECT. ROUTE ALL PATHWAYS WITHIN STUD CAVITIES OR ABOVE FINISHED CEILINGS.

### KEYED NOTES:

- 1. CONTINUE CIRCUIT UP THROUGH THE STAIRWELL.
- EXTERIOR BUILDING LIGHTS TO BE CONTROLLED VIA INTEGRAL AND/OR REMOTE PHOTOCELL FOR DUSK-TILL-DAWN OPERATION. REFER TO LIGHT FIXTURE SCHEDULE ON SHEET E1.21 FOR ADDITIONAL INFORMATION.
- 3. LIGHT FIXTURES IN THIS SPACE CONTROLLED BY CEILING MOUNT OCCUPANCY SENSOR.
- 4. PROVIDE PHOTOCELL FOR DAY-LIGHT REDUCTION OF LIGHT LEVELS.
- 5. CONTRACTOR TO COORDINATE WITH LANDSCAPE LIGHTING INSTALLER AND PROVIDE ROUGH-IN AND POWER CONNECTION(S) AS REQUIRED.
- 6. REFER TO SHEET E1.12 FOR TYPICAL DWELLING UNIT LOAD CENTER SCHEDULE FOR CIRCUITING INFORMATION.
- 7. REFER TO THE E3 SERIES SHEETS FOR TYPICAL DWELLING UNIT POWER DEVICE LAYOUT.
- 8. CORRIDOR LIGHTING CIRCUITS FOR THE UPPER FLOORS ARE AS FOLLOWS:

NORMAL POWER FLOORS 3, 4, 5 = HP1-7EGRESS POWER FLOORS 3, 4, 5 = EP2-11FLOORS 6, 7, 8 = EP2-13FLOORS 6, 7, 8 = HP1-9FLOORS 9, 10, 11, FLOORS 9, 10, 11, 12 & ROOF = HP1-11 12 & ROOF = EP2-15

- CORRIDOR AND STAIRWELL LIGHT FIXTURES TO BE CONTROLLED SUCH THAT THE FIXTURES DIM BY 50% DURING PERIODS OF LOW ACTIVITY. UPON DETECTION, LIGHTS SHALL RETURN TO 100% AND REMAIN AT FULL OUTPUT FOR A MINIMUM OF 30 MINUTES BEFORE RETURNING TO THE DIMMED STATE. FIXTURES ON EMERGENCY POWER CIRCUITS SHALL REMAIN 'ON' 24/7.
- 10. STROBE LIGHTS @ 24" AFF (BELOW SMOKE LING), AROUND PERIMETER FOR EGRESS. REFER TO 'T' SERIES SHEETS FOR MORE INFO. CIRCUIT TO PANEL 'VP'. SEE PANEL SCHEDULE ON SHEET E1.12.



OR 0

E S 1 20 **LIGHTIN** 


ARK



Consulting Engineers 2007 S.E. Ash St. Portland, OR 97214 PHN: (503) 234-0548 FAX: (503) 234-0677 WWW.MFIA-ENG.COM

SHEET

E2.01

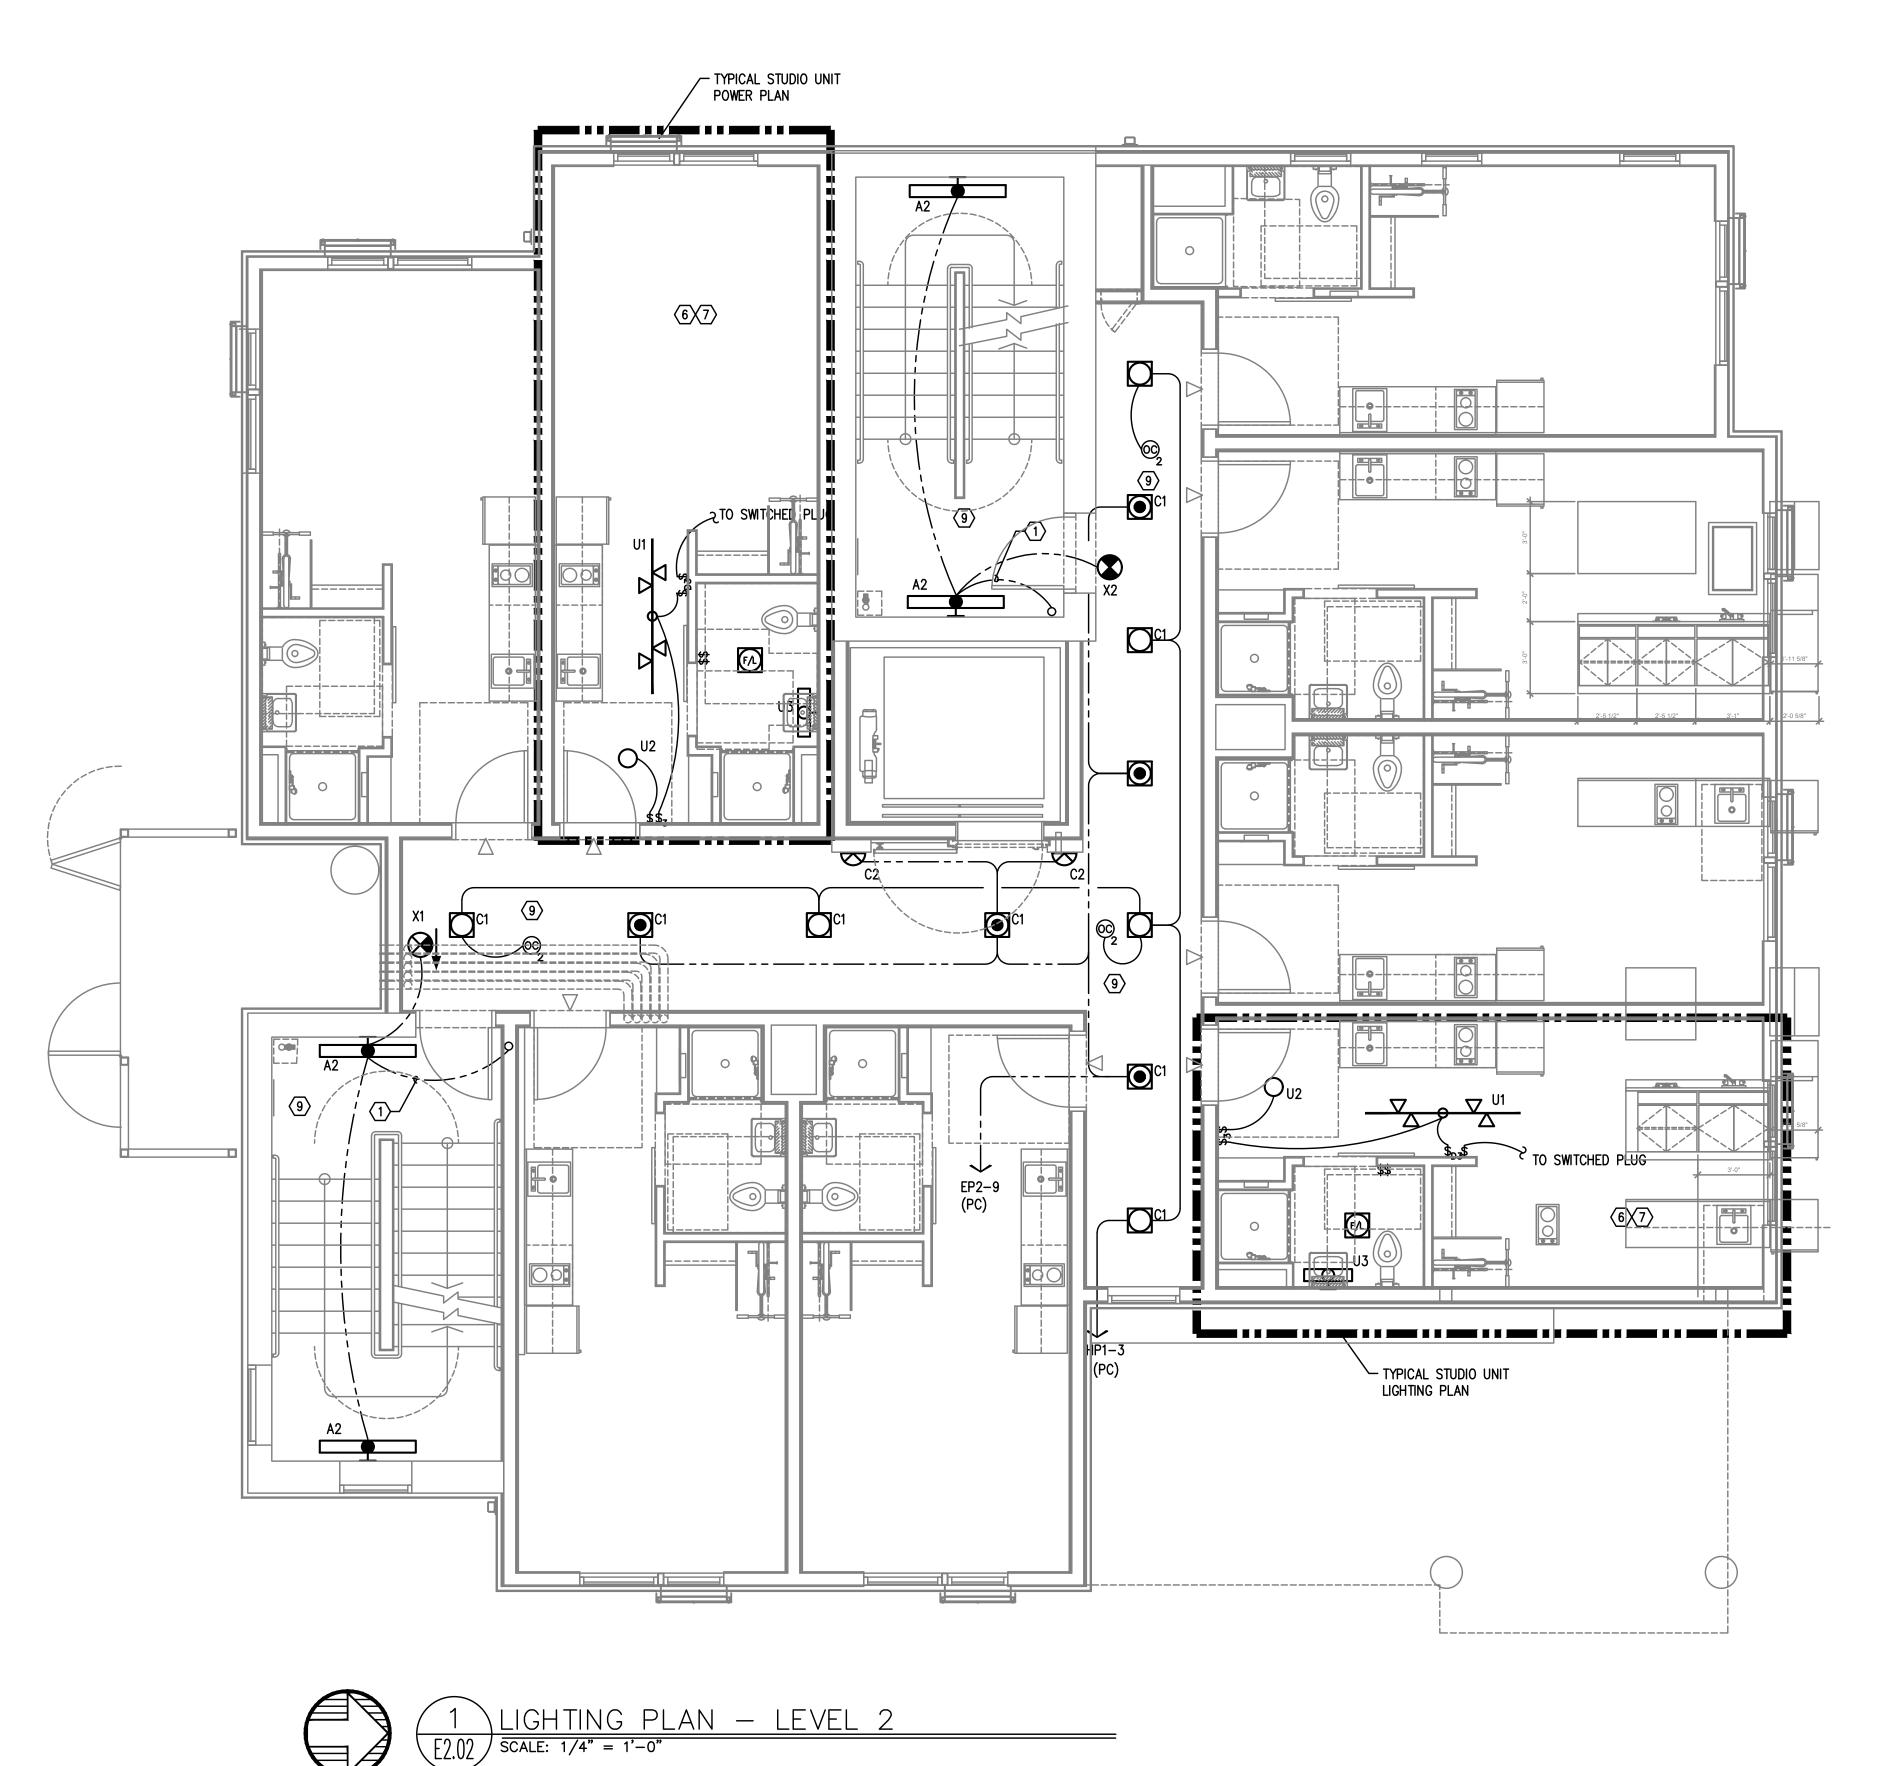



- A. ELECTRICAL DRAWINGS ARE DIAGRAMMATICAL AND MAY NOT ACCURATELY REFLECT ACTUAL CONSTRUCTION CONDITIONS. THE ELECTRICAL CONTRACTOR SHALL BE RESPONSIBLE FOR COORDINATING THE INSTALLATION OF ALL ELECTRICAL EQUIPMENT, WITH ALL TRADES PRIOR TO AND DURING CONSTRUCTION.
- B. THE ELECTRICAL CONTRACTOR SHALL REFER TO THE ARCHITECTURAL & INTERIOR DESIGN DRAWINGS FOR EXACT LOCATIONS, MOUNTING HEIGHTS AND FINISHES OF DEVICES AND FIXTURES.
- C. REFER TO ARCHITECTURAL INTERIOR ELEVATION PLANS FOR EXACT LOCATIONS OF FIXTURES AND DEVICES.
- D. REFER TO SHEET E1.21 FOR LIGHT FIXTURE SCHEDULE.
- E. REFER TO AVAILABLE ARCHITECTURAL AND/OR INTERIOR DESIGN DOCUMENTS & DRAWINGS FOR ADDITIONAL INFORMATION.
- F. OCCUPANCY SENSORS SHALL BE FIELD ADJUSTED TO ENSURE PROPER COVERAGE AND CONTROL.
- G. PROVIDE DIGITAL LIGHTING CONTROLS FOR EACH ROOM/SPACE, CONSISTING OF MULTI-BUTTON SWITCH(ES), OCC SENSORS, POWER PACKS, DAYLIGHT SENSORS, DIMMERS, INTERCONNECTING WIRING, ETC.
- H. CORRIDOR LIGHTING TO BE CONSTANT "ON" AND PROVIDED WITH LOCAL MANUAL OVERRIDE SWITCHES FOR MAINTENANCE. REFER TO SHEET E1.22 FOR SWITCH WIRING DIAGRAMS.
- I. ALL EGRESS FIXTURES SHALL BE WIRED SUCH THAT IN THE EVENT OF A POWER FAILURE, ALL LIGHTS WILL AUTOMATICALLY RETURN TO FULL POWER. REFER TO SWITCHING DETAILS ON SHEET E1.22.
- J. REFER TO SHEET E1.23 FOR LIGHTING CONTROL DIAGRAMS AND DESIGN INTENT. VERIFY LIGHTING CONTROLLABILITY WITH ARCHITECT AND/OR OWNER'S REPRESENTATIVE TO DETERMINE EXACT NEEDS FOR ALL PUBLIC/COMMON AREAS SUCH AS LOBBIES, OFFICES, LOUNGE AREAS, ETC., PRIOR TO THE START OF ANY WORK.
- K. THERE SHALL BE NO SURFACE MOUNTED FIXTURES OR PATHWAYS (CONDUIT, ETC.) IN ANY PUBLICLY ACCESSIBLE SPACES, INCLUDING STAIRWELLS AND EXIT PASSAGEWAYS WITHOUT PRIOR APPROVAL BY OWNER AND ARCHITECT. ROUTE ALL PATHWAYS WITHIN STUD CAVITIES OR ABOVE FINISHED CEILINGS.

### > KEYED NOTES

- 1. CONTINUE CIRCUIT UP THROUGH THE STAIRWELL.
- 2. EXTERIOR BUILDING LIGHTS TO BE CONTROLLED VIA INTEGRAL AND/OR REMOTE PHOTOCELL FOR DUSK-TILL-DAWN OPERATION. REFER TO LIGHT FIXTURE SCHEDULE ON SHEET E1.21 FOR ADDITIONAL INFORMATION.
- 3. LIGHT FIXTURES IN THIS SPACE CONTROLLED BY CEILING MOUNT OCCUPANCY SENSOR.
- 4. PROVIDE PHOTOCELL FOR DAY-LIGHT REDUCTION OF LIGHT LEVELS.
- 5. CONTRACTOR TO COORDINATE WITH LANDSCAPE LIGHTING INSTALLER AND PROVIDE ROUGH—IN AND POWER CONNECTION(S) AS REQUIRED.
- 6. REFER TO SHEET E1.12 FOR TYPICAL DWELLING UNIT LOAD CENTER SCHEDULE FOR CIRCUITING INFORMATION.
- 7. REFER TO THE E3 SERIES SHEETS FOR TYPICAL DWELLING UNIT POWER DEVICE LAYOUT.
- 8. CORRIDOR LIGHTING CIRCUITS FOR THE UPPER FLOORS ARE AS FOLLOWS:

NORMAL POWER

FLOORS 3, 4, 5 = HP1-7

FLOORS 6, 7, 8 = HP1-9

FLOORS 9, 10, 11,

12 & ROOF = HP1-11

FLOORS 9, 10, 11,

12 & ROOF = EP2-15

- OCORRIDOR AND STAIRWELL LIGHT FIXTURES TO BE CONTROLLED SUCH THAT THE FIXTURES DIM BY 50% DURING PERIODS OF LOW ACTIVITY. UPON DETECTION, LIGHTS SHALL RETURN TO 100% AND REMAIN AT FULL OUTPUT FOR A MINIMUM OF 30 MINUTES BEFORE RETURNING TO THE DIMMED STATE. FIXTURES ON EMERGENCY POWER CIRCUITS SHALL REMAIN 'ON' 24/7.
- 10. STROBE LIGHTS @ 24" AFF (BELOW SMOKE LING), AROUND PERIMETER FOR EGRESS. REFER TO 'T' SERIES SHEETS FOR MORE INFO. CIRCUIT TO PANEL 'VP'. SEE PANEL SCHEDULE ON SHEET E1.12.



. 04.14.2022 PERMIT RESUBMITTAL

vn By: DMT
d By: RLC
N By: DMT

OREGON FLOOR

SW PARK AVE.

OR

N - SECOND F

ORTLAND
LIGHTING P


1



Consulting Engineers 2007 S.E. Ash St. Portland, OR 97214 PHN: (503) 234-0548 FAX: (503) 234-0677 WWW.MFIA-ENG.COM

SHEET

E2.02

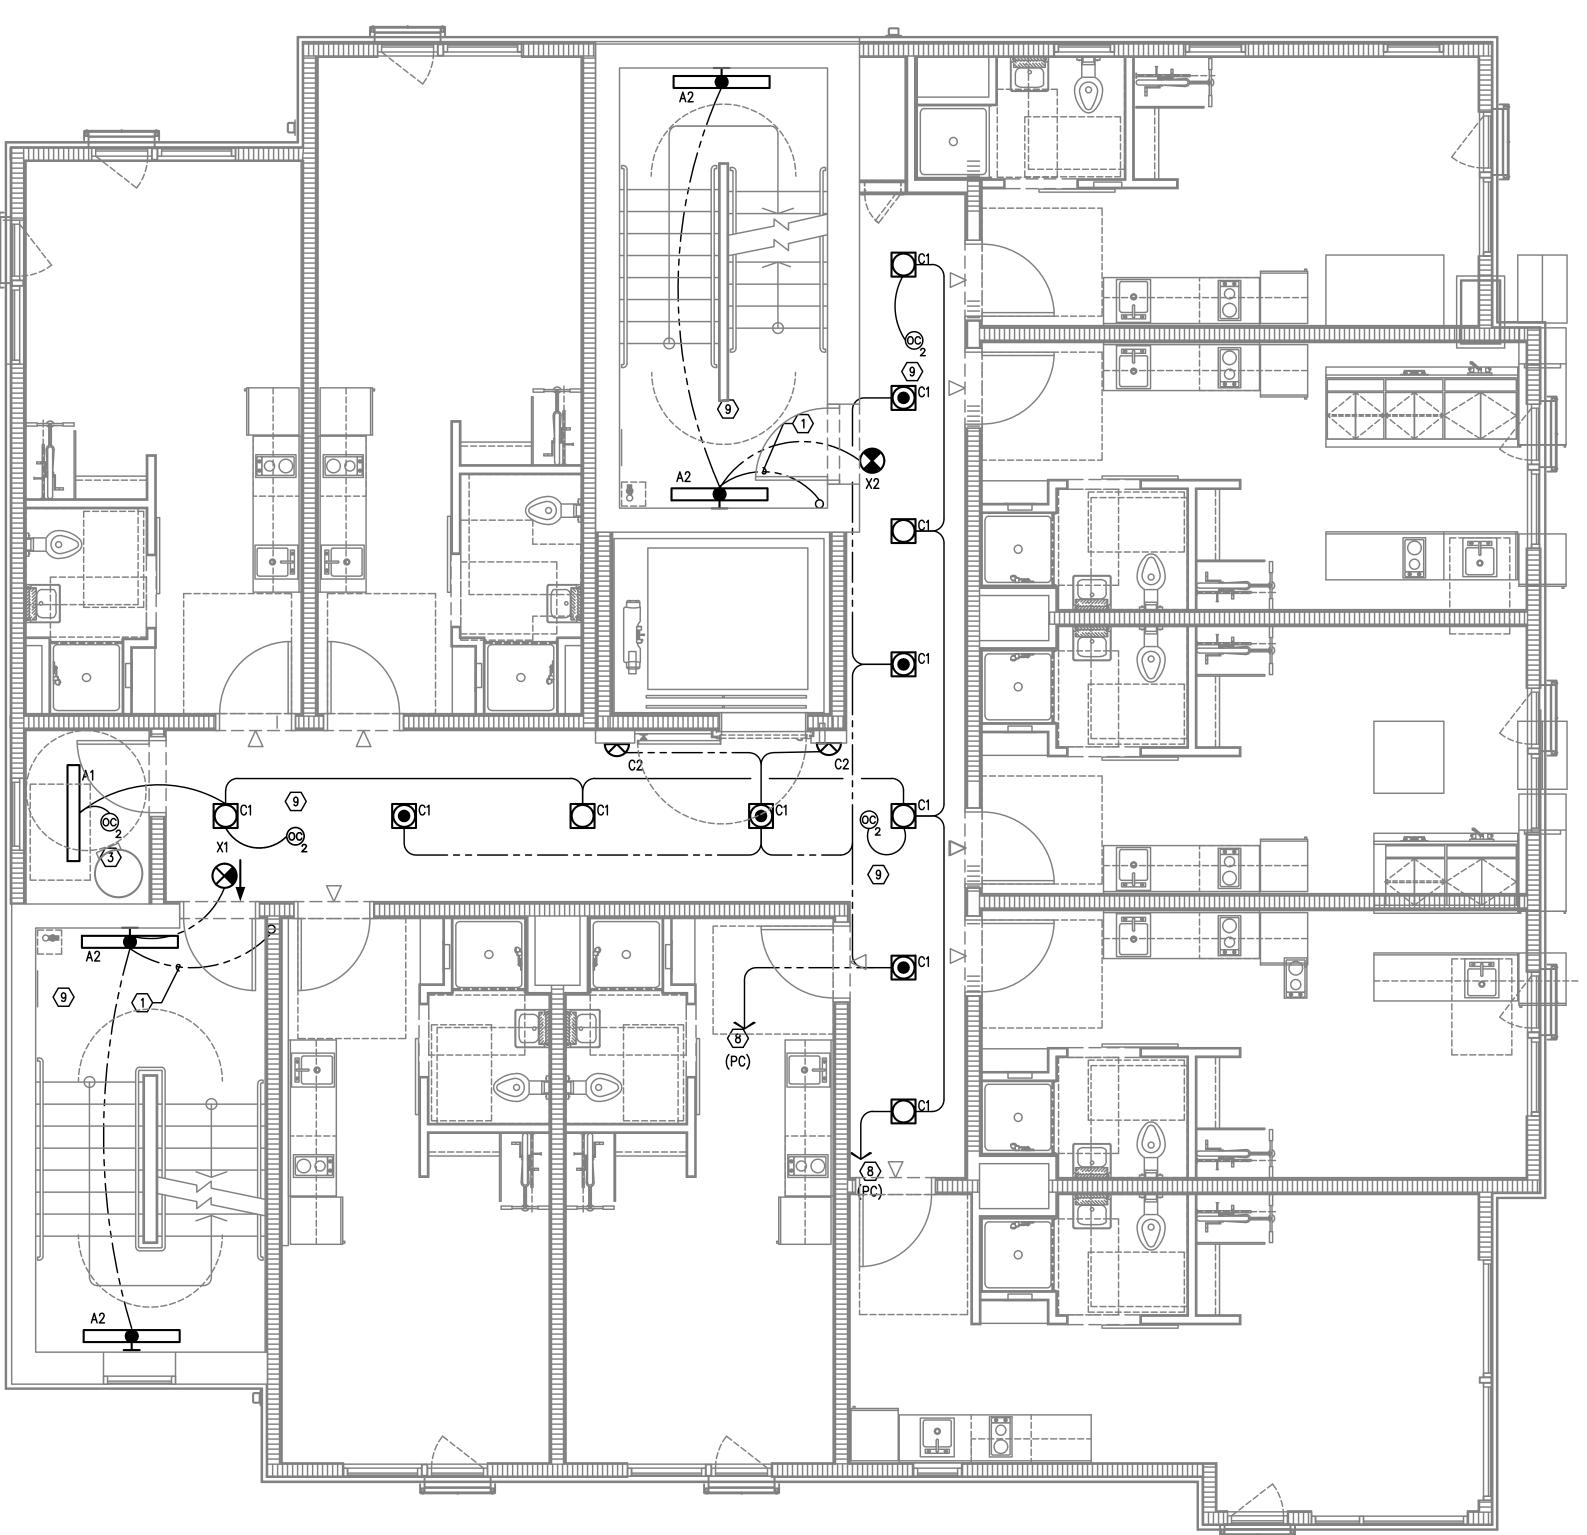

- A. ELECTRICAL DRAWINGS ARE DIAGRAMMATICAL AND MAY NOT ACCURATELY REFLECT ACTUAL CONSTRUCTION CONDITIONS. THE ELECTRICAL CONTRACTOR SHALL BE RESPONSIBLE FOR COORDINATING THE INSTALLATION OF ALL ELECTRICAL EQUIPMENT, WITH ALL TRADES PRIOR TO AND DURING CONSTRUCTION.
- B. THE ELECTRICAL CONTRACTOR SHALL REFER TO THE ARCHITECTURAL & INTERIOR DESIGN DRAWINGS FOR EXACT LOCATIONS, MOUNTING HEIGHTS AND FINISHES OF DEVICES AND FIXTURES.
- C. REFER TO ARCHITECTURAL INTERIOR ELEVATION PLANS FOR EXACT LOCATIONS OF FIXTURES AND
- D. REFER TO SHEET E1.21 FOR LIGHT FIXTURE SCHEDULE.
- E. REFER TO AVAILABLE ARCHITECTURAL AND/OR INTERIOR DESIGN DOCUMENTS & DRAWINGS FOR ADDITIONAL INFORMATION.
- F. OCCUPANCY SENSORS SHALL BE FIELD ADJUSTED TO ENSURE PROPER COVERAGE AND CONTROL
- G. PROVIDE DIGITAL LIGHTING CONTROLS FOR EACH ROOM/SPACE, CONSISTING OF MULTI-BUTTON SWITCH(ES), OCC SENSORS, POWER PACKS, DAYLIGHT SENSORS, DIMMERS, INTERCONNECTING WIRING, ETC.
- H. CORRIDOR LIGHTING TO BE CONSTANT "ON" AND PROVIDED WITH LOCAL MANUAL OVERRIDE SWITCHES FOR MAINTENANCE. REFER TO SHEET E1.22 FOR SWITCH WIRING DIAGRAMS.
- I. ALL EGRESS FIXTURES SHALL BE WIRED SUCH THAT IN THE EVENT OF A POWER FAILURE, ALL LIGHTS WILL AUTOMATICALLY RETURN TO FULL POWER. REFER TO SWITCHING DETAILS ON SHEET E1.22.
- J. REFER TO SHEET E1.23 FOR LIGHTING CONTROL DIAGRAMS AND DESIGN INTENT. VERIFY LIGHTING CONTROLLABILITY WITH ARCHITECT AND/OR OWNER'S REPRESENTATIVE TO DETERMINE EXACT NEEDS FOR ALL PUBLIC/COMMON AREAS SUCH AS LOBBIES, OFFICES, LOUNGE AREAS, ETC., PRIOR TO THE START OF ANY WORK.
- K. THERE SHALL BE NO SURFACE MOUNTED FIXTURES OR PATHWAYS (CONDUIT, ETC.) IN ANY PUBLICLY ACCESSIBLE SPACES, INCLUDING STAIRWELLS AND EXIT PASSAGEWAYS WITHOUT PRIOR APPROVAL BY OWNER AND ARCHITECT. ROUTE ALL PATHWAYS WITHIN STUD CAVITIES OR ABOVE FINISHED CEILINGS.

### 

- 1. CONTINUE CIRCUIT UP THROUGH THE STAIRWELL.
- 2. EXTERIOR BUILDING LIGHTS TO BE CONTROLLED VIA INTEGRAL AND/OR REMOTE PHOTOCELL FOR DUSK-TILL-DAWN OPERATION. REFER TO LIGHT FIXTURE SCHEDULE ON SHEET E1.21 FOR ADDITIONAL INFORMATION.
- 3. LIGHT FIXTURES IN THIS SPACE CONTROLLED BY CEILING MOUNT OCCUPANCY SENSOR.
- 4. PROVIDE PHOTOCELL FOR DAY-LIGHT REDUCTION OF LIGHT LEVELS.
- 5. CONTRACTOR TO COORDINATE WITH LANDSCAPE LIGHTING INSTALLER AND PROVIDE ROUGH—IN AND POWER CONNECTION(S) AS REQUIRED.
- 6. REFER TO SHEET E1.12 FOR TYPICAL DWELLING UNIT LOAD CENTER SCHEDULE FOR CIRCUITING INFORMATION.
- 7. REFER TO THE E3 SERIES SHEETS FOR TYPICAL DWELLING UNIT POWER DEVICE LAYOUT.
- 8. CORRIDOR LIGHTING CIRCUITS FOR THE UPPER FLOORS ARE AS FOLLOWS:

NORMAL POWER

FLOORS 3, 4, 5 = HP1-7

FLOORS 6, 7, 8 = HP1-9

FLOORS 9, 10, 11,

12 & ROOF = HP1-11

FLOORS 9, 10, 11,

12 & ROOF = EP2-15

- CORRIDOR AND STAIRWELL LIGHT FIXTURES TO BE CONTROLLED SUCH THAT THE FIXTURES DIM BY 50% DURING PERIODS OF LOW ACTIVITY. UPON DETECTION, LIGHTS SHALL RETURN TO 100% AND REMAIN AT FULL OUTPUT FOR A MINIMUM OF 30 MINUTES BEFORE RETURNING TO THE DIMMED STATE. FIXTURES ON EMERGENCY POWER CIRCUITS SHALL REMAIN 'ON' 24/7.
- 10. STROBE LIGHTS @ 24" AFF (BELOW SMOKE LING), AROUND PERIMETER FOR EGRESS. REFER TO 'T' SERIES SHEETS FOR MORE INFO. CIRCUIT TO PANEL 'VP'. SEE PANEL SCHEDULE ON SHEET E1.12.



Drawn By: DICHKA By: REDICHES

OREGON 3-6

V PAKK AVE.

V — FLOORS

RYSTAI 2057 SW PAI

\TLAND


LIGHTIN




Consulting Engineers 2007 S.E. Ash St. Portland, OR 97214 PHN: (503) 234-0548 FAX: (503) 234-0677 WWW.MFIA-ENG.COM

SHEET

E2.03

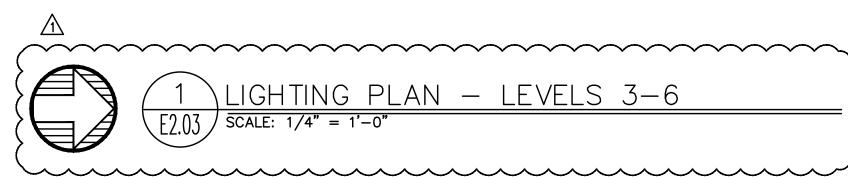

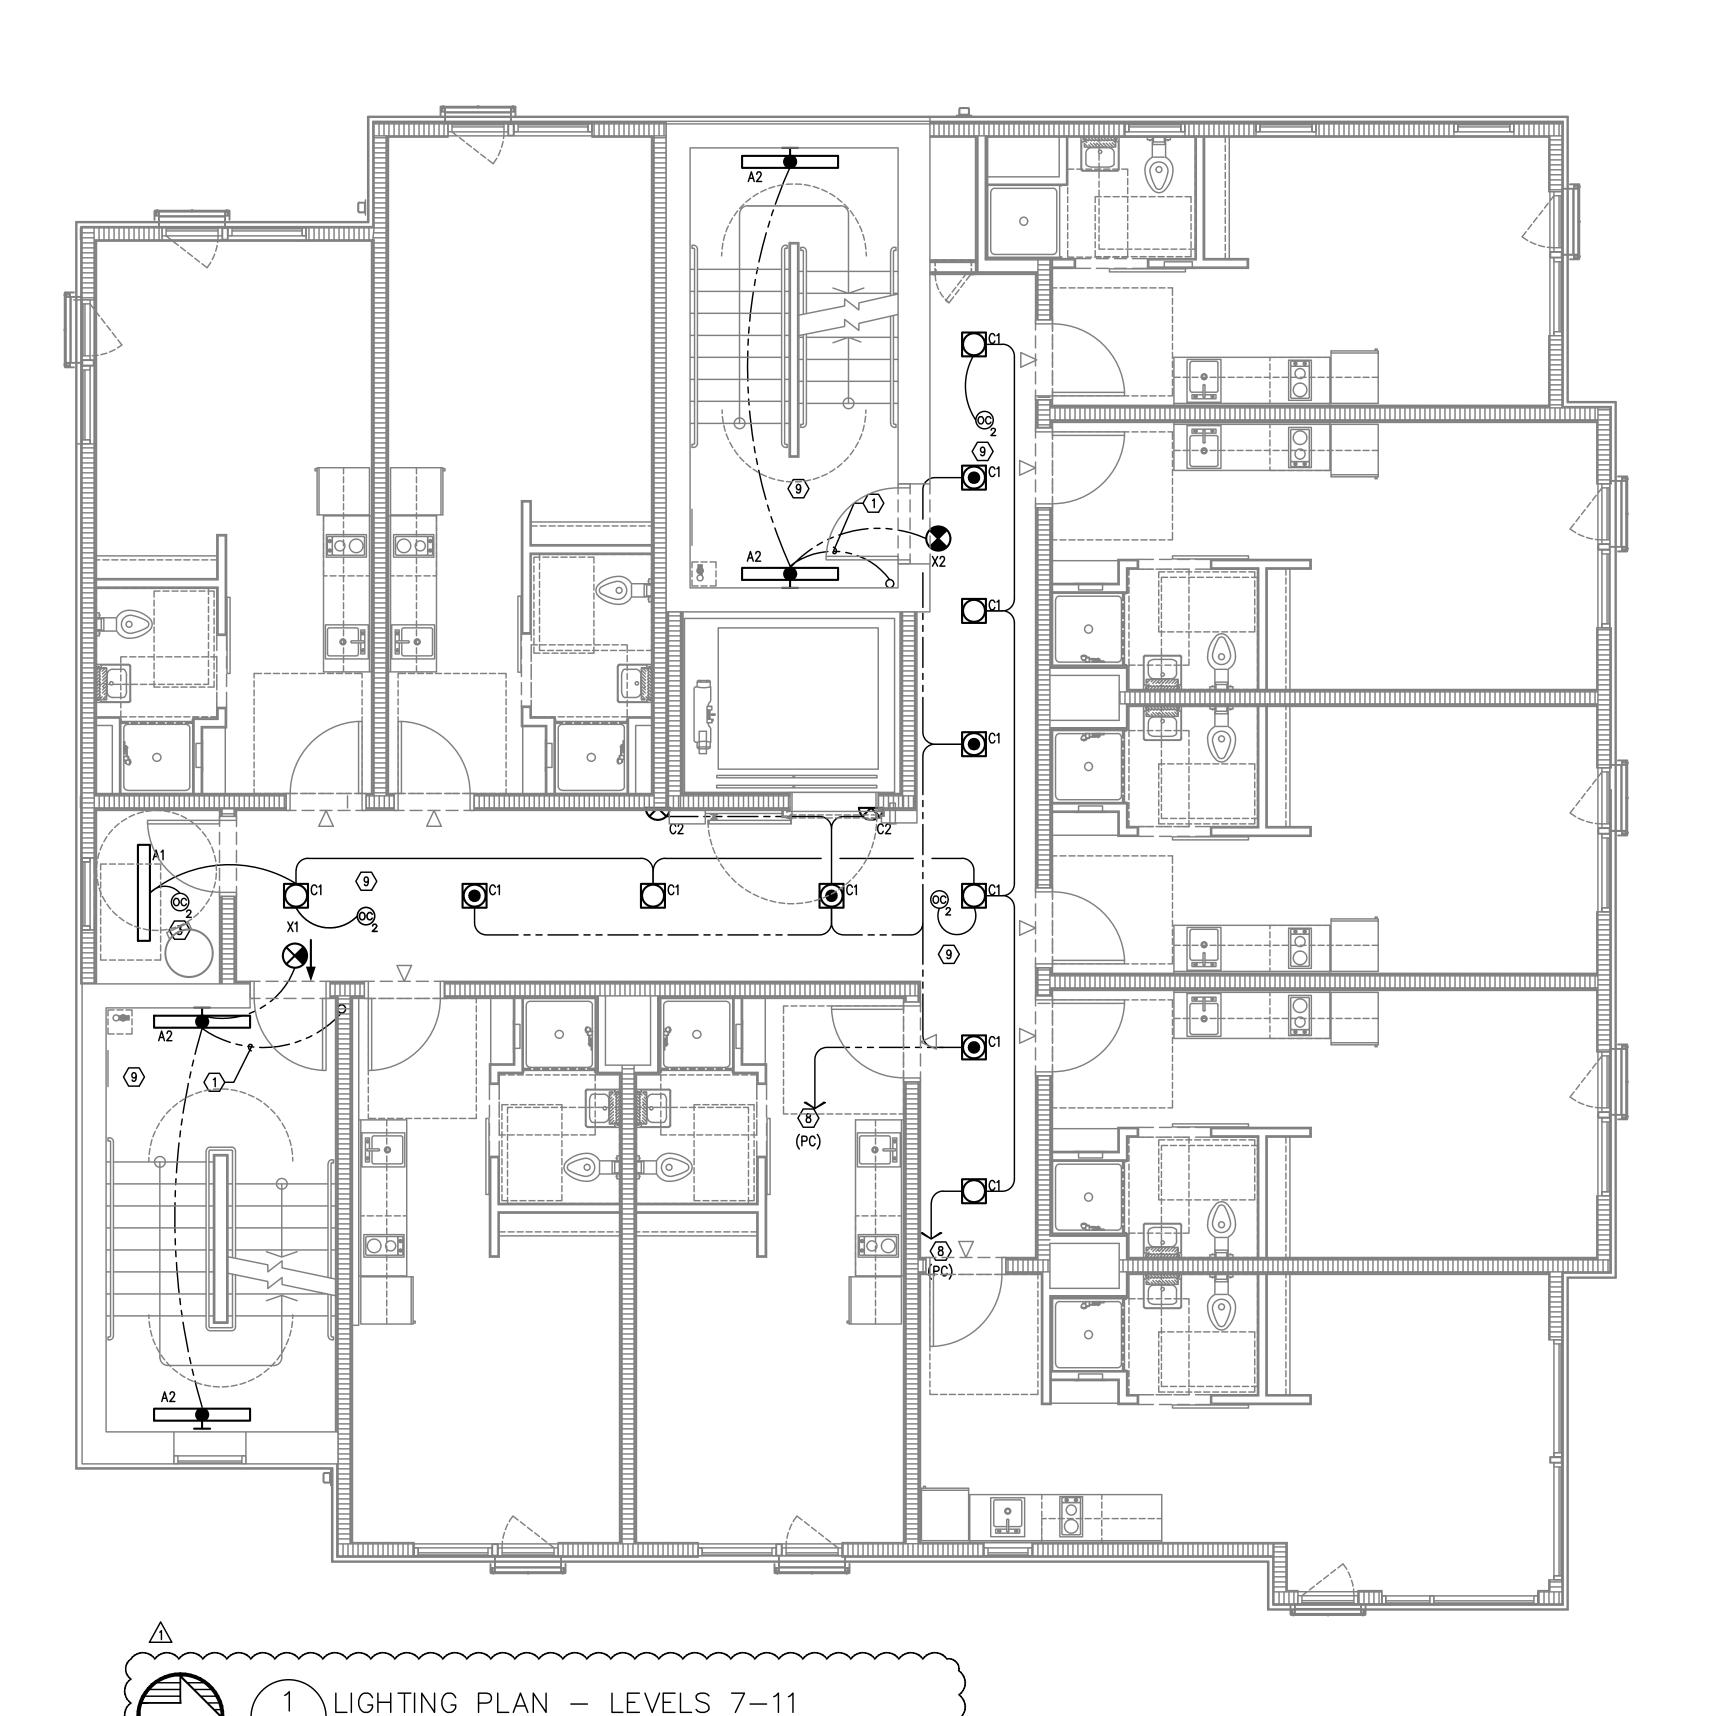

### GENERAL LIGHTING NOTES:

- A. ELECTRICAL DRAWINGS ARE DIAGRAMMATICAL AND MAY NOT ACCURATELY REFLECT ACTUAL CONSTRUCTION CONDITIONS. THE ELECTRICAL CONTRACTOR SHALL BE RESPONSIBLE FOR COORDINATING THE INSTALLATION OF ALL ELECTRICAL EQUIPMENT, WITH ALL TRADES PRIOR TO AND DURING CONSTRUCTION.
- B. THE ELECTRICAL CONTRACTOR SHALL REFER TO THE ARCHITECTURAL & INTERIOR DESIGN DRAWINGS FOR EXACT LOCATIONS, MOUNTING HEIGHTS AND FINISHES OF DEVICES AND FIXTURES.
- C. REFER TO ARCHITECTURAL INTERIOR ELEVATION PLANS FOR EXACT LOCATIONS OF FIXTURES AND
- D. REFER TO SHEET E1.21 FOR LIGHT FIXTURE SCHEDULE.
- E. REFER TO AVAILABLE ARCHITECTURAL AND/OR INTERIOR DESIGN DOCUMENTS & DRAWINGS FOR ADDITIONAL INFORMATION.
- F. OCCUPANCY SENSORS SHALL BE FIELD ADJUSTED TO ENSURE PROPER COVERAGE AND CONTROL
- G. PROVIDE DIGITAL LIGHTING CONTROLS FOR EACH ROOM/SPACE, CONSISTING OF MULTI-BUTTON SWITCH(ES), OCC SENSORS, POWER PACKS, DAYLIGHT SENSORS, DIMMERS, INTERCONNECTING WIRING, ETC.
- H. CORRIDOR LIGHTING TO BE CONSTANT "ON" AND PROVIDED WITH LOCAL MANUAL OVERRIDE SWITCHES FOR MAINTENANCE. REFER TO SHEET E1.22 FOR SWITCH WIRING DIAGRAMS.
- I. ALL EGRESS FIXTURES SHALL BE WIRED SUCH THAT IN THE EVENT OF A POWER FAILURE, ALL LIGHTS WILL AUTOMATICALLY RETURN TO FULL POWER. REFER TO SWITCHING DETAILS ON SHEET E1.22.
- J. REFER TO SHEET E1.23 FOR LIGHTING CONTROL DIAGRAMS AND DESIGN INTENT. VERIFY LIGHTING CONTROLLABILITY WITH ARCHITECT AND/OR OWNER'S REPRESENTATIVE TO DETERMINE EXACT NEEDS FOR ALL PUBLIC/COMMON AREAS SUCH AS LOBBIES, OFFICES, LOUNGE AREAS, ETC., PRIOR TO THE START OF ANY WORK.
- K. THERE SHALL BE NO SURFACE MOUNTED FIXTURES OR PATHWAYS (CONDUIT, ETC.) IN ANY PUBLICLY ACCESSIBLE SPACES, INCLUDING STAIRWELLS AND EXIT PASSAGEWAYS WITHOUT PRIOR APPROVAL BY OWNER AND ARCHITECT. ROUTE ALL PATHWAYS WITHIN STUD CAVITIES OR ABOVE FINISHED CEILINGS.

### 

- 1. CONTINUE CIRCUIT UP THROUGH THE STAIRWELL.
- 2. EXTERIOR BUILDING LIGHTS TO BE CONTROLLED VIA INTEGRAL AND/OR REMOTE PHOTOCELL FOR DUSK-TILL-DAWN OPERATION. REFER TO LIGHT FIXTURE SCHEDULE ON SHEET E1.21 FOR ADDITIONAL INFORMATION.
- 3. LIGHT FIXTURES IN THIS SPACE CONTROLLED BY CEILING MOUNT OCCUPANCY SENSOR.
- 4. PROVIDE PHOTOCELL FOR DAY-LIGHT REDUCTION OF LIGHT LEVELS.
- 5. CONTRACTOR TO COORDINATE WITH LANDSCAPE LIGHTING INSTALLER AND PROVIDE ROUGH—IN AND POWER CONNECTION(S) AS REQUIRED.
- 6. REFER TO SHEET E1.12 FOR TYPICAL DWELLING UNIT LOAD CENTER SCHEDULE FOR CIRCUITING INFORMATION.
- 7. REFER TO THE E3 SERIES SHEETS FOR TYPICAL DWELLING UNIT POWER DEVICE LAYOUT.
- 8. CORRIDOR LIGHTING CIRCUITS FOR THE UPPER FLOORS ARE AS FOLLOWS:

NORMAL POWER

FLOORS 3, 4, 5 = HP1-7

FLOORS 6, 7, 8 = HP1-9

FLOORS 9, 10, 11,

12 & ROOF = HP1-11

FGRESS POWER


FLOORS 3, 4, 5 = EP2-11

FLOORS 6, 7, 8 = EP2-13

FLOORS 9, 10, 11,

12 & ROOF = EP2-15

- 9. CORRIDOR AND STAIRWELL LIGHT FIXTURES TO BE CONTROLLED SUCH THAT THE FIXTURES DIM BY 50% DURING PERIODS OF LOW ACTIVITY. UPON DETECTION, LIGHTS SHALL RETURN TO 100% AND REMAIN AT FULL OUTPUT FOR A MINIMUM OF 30 MINUTES BEFORE RETURNING TO THE DIMMED STATE. FIXTURES ON EMERGENCY POWER CIRCUITS SHALL REMAIN 'ON' 24/7.
- 10. STROBE LIGHTS @ 24" AFF (BELOW SMOKE LING), AROUND PERIMETER FOR EGRESS. REFER TO 'T' SERIES SHEETS FOR MORE INFO. CIRCUIT TO PANEL 'VP'. SEE PANEL SCHEDULE ON SHEET E1.12.

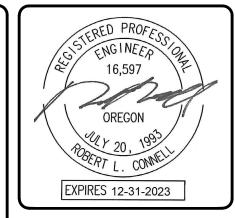

Drawn By: DMT
Chkd By: RLC
DSGN By: DMT
Acad File:

OREGON

SW PARK AVE.

NA - FLOORS

**2057** 


**LIGHTIN** 

M

Consulting Engineers 2007 S.E. Ash St. Portland, OR 97214 PHN: (503) 234-0548 FAX: (503) 234-0677 WWW.MFIA-ENG.COM

SHEET

E2.04

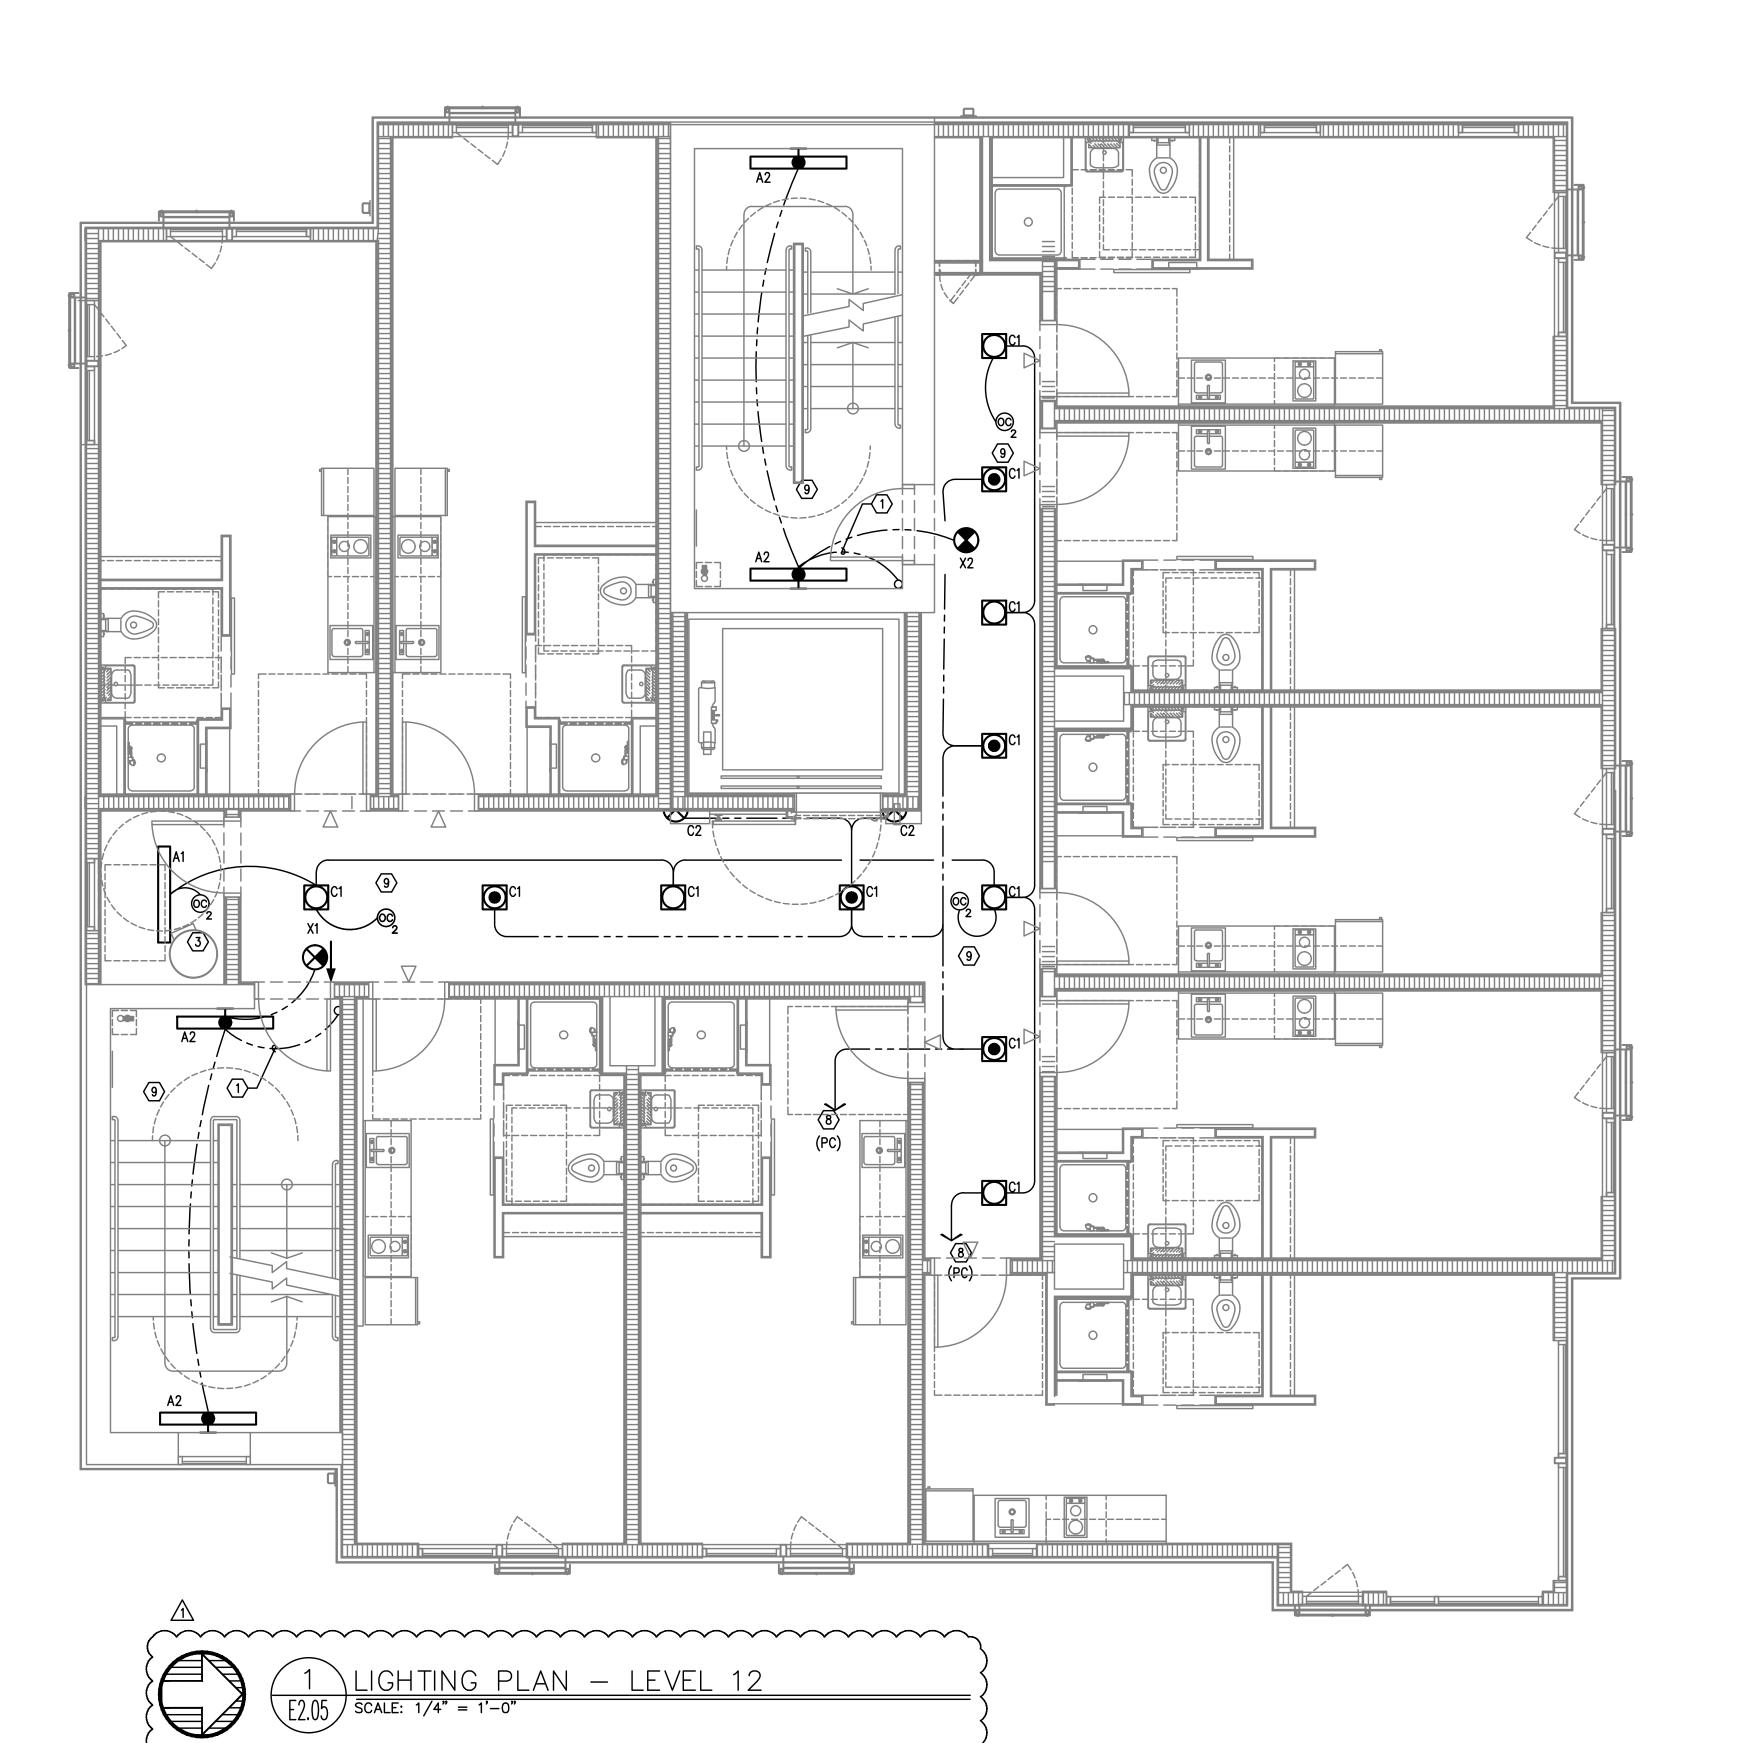

### GENERAL LIGHTING NOTES:

- A. ELECTRICAL DRAWINGS ARE DIAGRAMMATICAL AND MAY NOT ACCURATELY REFLECT ACTUAL CONSTRUCTION CONDITIONS. THE ELECTRICAL CONTRACTOR SHALL BE RESPONSIBLE FOR COORDINATING THE INSTALLATION OF ALL ELECTRICAL EQUIPMENT, WITH ALL TRADES PRIOR TO AND DURING CONSTRUCTION.
- B. THE ELECTRICAL CONTRACTOR SHALL REFER TO THE ARCHITECTURAL & INTERIOR DESIGN DRAWINGS FOR EXACT LOCATIONS, MOUNTING HEIGHTS AND FINISHES OF DEVICES AND FIXTURES.
- C. REFER TO ARCHITECTURAL INTERIOR ELEVATION PLANS FOR EXACT LOCATIONS OF FIXTURES AND
- D. REFER TO SHEET E1.21 FOR LIGHT FIXTURE SCHEDULE.
- E. REFER TO AVAILABLE ARCHITECTURAL AND/OR INTERIOR DESIGN DOCUMENTS & DRAWINGS FOR ADDITIONAL INFORMATION.
- F. OCCUPANCY SENSORS SHALL BE FIELD ADJUSTED TO ENSURE PROPER COVERAGE AND CONTROL.
- G. PROVIDE DIGITAL LIGHTING CONTROLS FOR EACH ROOM/SPACE, CONSISTING OF MULTI-BUTTON SWITCH(ES), OCC SENSORS, POWER PACKS, DAYLIGHT SENSORS, DIMMERS, INTERCONNECTING WIRING, ETC.
- H. CORRIDOR LIGHTING TO BE CONSTANT "ON" AND PROVIDED WITH LOCAL MANUAL OVERRIDE SWITCHES FOR MAINTENANCE. REFER TO SHEET E1.22 FOR SWITCH WIRING DIAGRAMS.
- I. ALL EGRESS FIXTURES SHALL BE WIRED SUCH THAT IN THE EVENT OF A POWER FAILURE, ALL LIGHTS WILL AUTOMATICALLY RETURN TO FULL POWER. REFER TO SWITCHING DETAILS ON SHEET E1.22.
- J. REFER TO SHEET E1.23 FOR LIGHTING CONTROL DIAGRAMS AND DESIGN INTENT. VERIFY LIGHTING CONTROLLABILITY WITH ARCHITECT AND/OR OWNER'S REPRESENTATIVE TO DETERMINE EXACT NEEDS FOR ALL PUBLIC/COMMON AREAS SUCH AS LOBBIES, OFFICES, LOUNGE AREAS, ETC., PRIOR TO THE START OF ANY WORK.
- K. THERE SHALL BE NO SURFACE MOUNTED FIXTURES OR PATHWAYS (CONDUIT, ETC.) IN ANY PUBLICLY ACCESSIBLE SPACES, INCLUDING STAIRWELLS AND EXIT PASSAGEWAYS WITHOUT PRIOR APPROVAL BY OWNER AND ARCHITECT. ROUTE ALL PATHWAYS WITHIN STUD CAVITIES OR ABOVE FINISHED CEILINGS.

### KEYED NOTES:

- 1. CONTINUE CIRCUIT UP THROUGH THE STAIRWELL.
- EXTERIOR BUILDING LIGHTS TO BE CONTROLLED VIA INTEGRAL AND/OR REMOTE PHOTOCELL FOR DUSK-TILL-DAWN OPERATION. REFER TO LIGHT FIXTURE SCHEDULE ON SHEET E1.21 FOR ADDITIONAL INFORMATION.
- 3. LIGHT FIXTURES IN THIS SPACE CONTROLLED BY CEILING MOUNT OCCUPANCY SENSOR.
- 4. PROVIDE PHOTOCELL FOR DAY-LIGHT REDUCTION OF LIGHT LEVELS.
- 5. CONTRACTOR TO COORDINATE WITH LANDSCAPE LIGHTING INSTALLER AND PROVIDE ROUGH—IN AND POWER CONNECTION(S) AS REQUIRED.
- 6. REFER TO SHEET E1.12 FOR TYPICAL DWELLING UNIT LOAD CENTER SCHEDULE FOR CIRCUITING INFORMATION.
- 7. REFER TO THE E3 SERIES SHEETS FOR TYPICAL DWELLING UNIT POWER DEVICE LAYOUT.
- 8. CORRIDOR LIGHTING CIRCUITS FOR THE UPPER FLOORS ARE AS FOLLOWS:

NORMAL POWER

FLOORS 3, 4, 5 = HP1-7

FLOORS 6, 7, 8 = HP1-9

FLOORS 9, 10, 11,

12 & ROOF = HP1-11

FLOORS 9, 10, 11,

12 & ROOF = EP2-15

- CORRIDOR AND STAIRWELL LIGHT FIXTURES TO BE CONTROLLED SUCH THAT THE FIXTURES DIM BY 50% DURING PERIODS OF LOW ACTIVITY. UPON DETECTION, LIGHTS SHALL RETURN TO 100% AND REMAIN AT FULL OUTPUT FOR A MINIMUM OF 30 MINUTES BEFORE RETURNING TO THE DIMMED STATE. FIXTURES ON EMERGENCY POWER CIRCUITS SHALL REMAIN 'ON' 24/7.
- 10. STROBE LIGHTS @ 24" AFF (BELOW SMOKE LING), AROUND PERIMETER FOR EGRESS. REFER TO 'T' SERIES SHEETS FOR MORE INFO. CIRCUIT TO PANEL 'VP'. SEE PANEL SCHEDULE ON SHEET E1.12.



| National | National 
Chkd DSGN Acad

> OREGON FLOOR

> > 2

RYSTADT 2057 SW PARK AVE.

**TLAND** 


LIGHTIN



Consulting Engineers 2007 S.E. Ash St. Portland, OR 97214 PHN: (503) 234-0548 FAX: (503) 234-0677 WWW.MFIA-ENG.COM

SHEET

E2.05

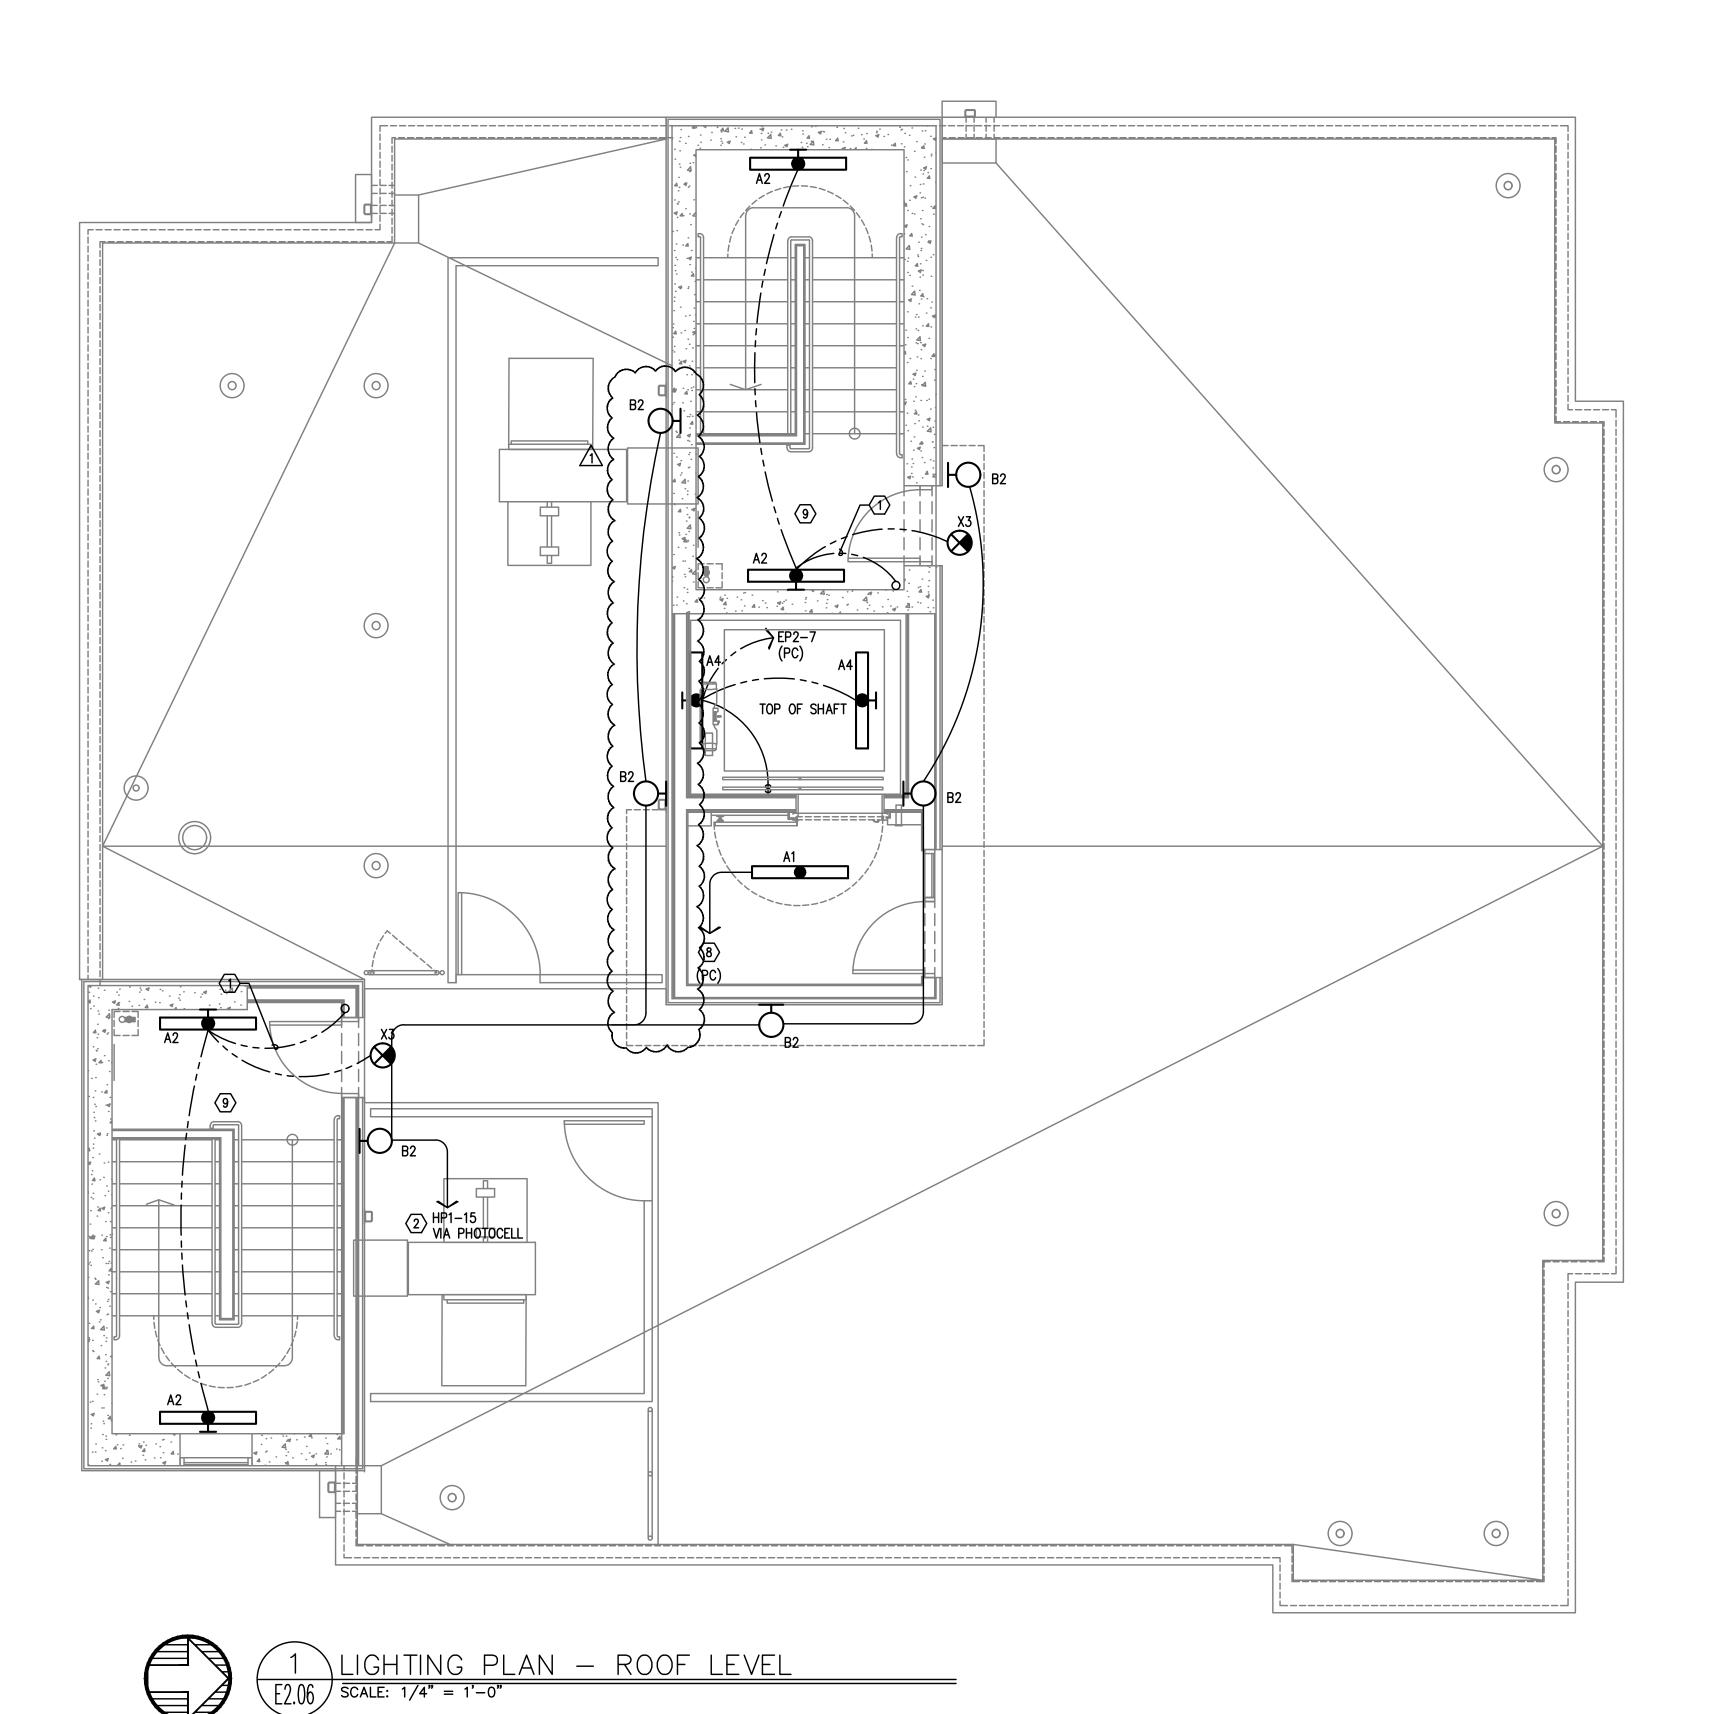

- A. ELECTRICAL DRAWINGS ARE DIAGRAMMATICAL AND MAY NOT ACCURATELY REFLECT ACTUAL CONSTRUCTION CONDITIONS. THE ELECTRICAL CONTRACTOR SHALL BE RESPONSIBLE FOR COORDINATING THE INSTALLATION OF ALL ELECTRICAL EQUIPMENT, WITH ALL TRADES PRIOR TO AND DURING CONSTRUCTION.
- B. THE ELECTRICAL CONTRACTOR SHALL REFER TO THE ARCHITECTURAL & INTERIOR DESIGN DRAWINGS FOR EXACT LOCATIONS, MOUNTING HEIGHTS AND FINISHES OF DEVICES AND FIXTURES.
- C. REFER TO ARCHITECTURAL INTERIOR ELEVATION PLANS FOR EXACT LOCATIONS OF FIXTURES AND
- D. REFER TO SHEET E1.21 FOR LIGHT FIXTURE SCHEDULE.
- E. REFER TO AVAILABLE ARCHITECTURAL AND/OR INTERIOR DESIGN DOCUMENTS & DRAWINGS FOR ADDITIONAL INFORMATION.
- F. OCCUPANCY SENSORS SHALL BE FIELD ADJUSTED TO ENSURE PROPER COVERAGE AND CONTROL
- G. PROVIDE DIGITAL LIGHTING CONTROLS FOR EACH ROOM/SPACE, CONSISTING OF MULTI-BUTTON SWITCH(ES), OCC SENSORS, POWER PACKS, DAYLIGHT SENSORS, DIMMERS, INTERCONNECTING WIRING, ETC.
- H. CORRIDOR LIGHTING TO BE CONSTANT "ON" AND PROVIDED WITH LOCAL MANUAL OVERRIDE SWITCHES FOR MAINTENANCE. REFER TO SHEET E1.22 FOR SWITCH WIRING DIAGRAMS.
- I. ALL EGRESS FIXTURES SHALL BE WIRED SUCH THAT IN THE EVENT OF A POWER FAILURE, ALL LIGHTS WILL AUTOMATICALLY RETURN TO FULL POWER. REFER TO SWITCHING DETAILS ON SHEET E1.22.
- J. REFER TO SHEET E1.23 FOR LIGHTING CONTROL DIAGRAMS AND DESIGN INTENT. VERIFY LIGHTING CONTROLLABILITY WITH ARCHITECT AND/OR OWNER'S REPRESENTATIVE TO DETERMINE EXACT NEEDS FOR ALL PUBLIC/COMMON AREAS SUCH AS LOBBIES, OFFICES, LOUNGE AREAS, ETC., PRIOR TO THE START OF ANY WORK.
- K. THERE SHALL BE NO SURFACE MOUNTED FIXTURES OR PATHWAYS (CONDUIT, ETC.) IN ANY PUBLICLY ACCESSIBLE SPACES, INCLUDING STAIRWELLS AND EXIT PASSAGEWAYS WITHOUT PRIOR APPROVAL BY OWNER AND ARCHITECT. ROUTE ALL PATHWAYS WITHIN STUD CAVITIES OR ABOVE FINISHED CEILINGS.


### > KEYED NOTES


- 1. CONTINUE CIRCUIT UP THROUGH THE STAIRWELL.
- EXTERIOR BUILDING LIGHTS TO BE CONTROLLED VIA INTEGRAL AND/OR REMOTE PHOTOCELL FOR DUSK-TILL-DAWN OPERATION. REFER TO LIGHT FIXTURE SCHEDULE ON SHEET E1.21 FOR ADDITIONAL INFORMATION.
- 3. LIGHT FIXTURES IN THIS SPACE CONTROLLED BY CEILING MOUNT OCCUPANCY SENSOR.
- 4. PROVIDE PHOTOCELL FOR DAY-LIGHT REDUCTION OF LIGHT LEVELS.
- 5. CONTRACTOR TO COORDINATE WITH LANDSCAPE LIGHTING INSTALLER AND PROVIDE ROUGH—IN AND POWER CONNECTION(S) AS REQUIRED.
- 6. REFER TO SHEET E1.12 FOR TYPICAL DWELLING UNIT LOAD CENTER SCHEDULE FOR CIRCUITING INFORMATION.
- 7. REFER TO THE E3 SERIES SHEETS FOR TYPICAL DWELLING UNIT POWER DEVICE LAYOUT.
- 8. CORRIDOR LIGHTING CIRCUITS FOR THE UPPER FLOORS ARE AS FOLLOWS:

NORMAL POWER
FLOORS 3, 4, 5 = HP1-7
FLOORS 6, 7, 8 = HP1-9
FLOORS 9, 10, 11,
12 & ROOF = HP1-11

EGRESS POWER
FLOORS 3, 4, 5 = EP2-11
FLOORS 6, 7, 8 = EP2-13
FLOORS 9, 10, 11,
12 & ROOF = EP2-15

- 9. CORRIDOR AND STAIRWELL LIGHT FIXTURES TO BE CONTROLLED SUCH THAT THE FIXTURES DIM BY 50% DURING PERIODS OF LOW ACTIVITY. UPON DETECTION, LIGHTS SHALL RETURN TO 100% AND REMAIN AT FULL OUTPUT FOR A MINIMUM OF 30 MINUTES BEFORE RETURNING TO THE DIMMED STATE. FIXTURES ON EMERGENCY POWER CIRCUITS SHALL REMAIN 'ON' 24/7.
- 10. STROBE LIGHTS @ 24" AFF (BELOW SMOKE LING), AROUND PERIMETER FOR EGRESS, REFER TO 'T' SERIES SHEETS FOR MORE INFO. CIRCUIT TO PANEL 'VP'. SEE PANEL SCHEDULE ON SHEET E1.12.

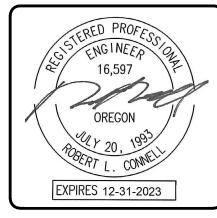

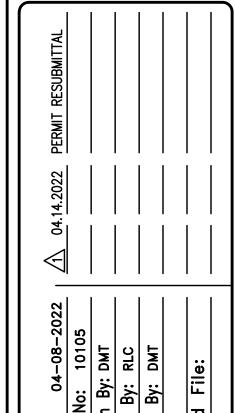

OREGON

RYSTADT

7 SW PARK AVE.

PLAN - ROOF

TLAND LIGHTIN


20



Consulting Engineers 2007 S.E. Ash St. Portland, OR 97214 PHN: (503) 234-0548 FAX: (503) 234-0677 WWW.MFIA-ENG.COM

SHEET

E2.06

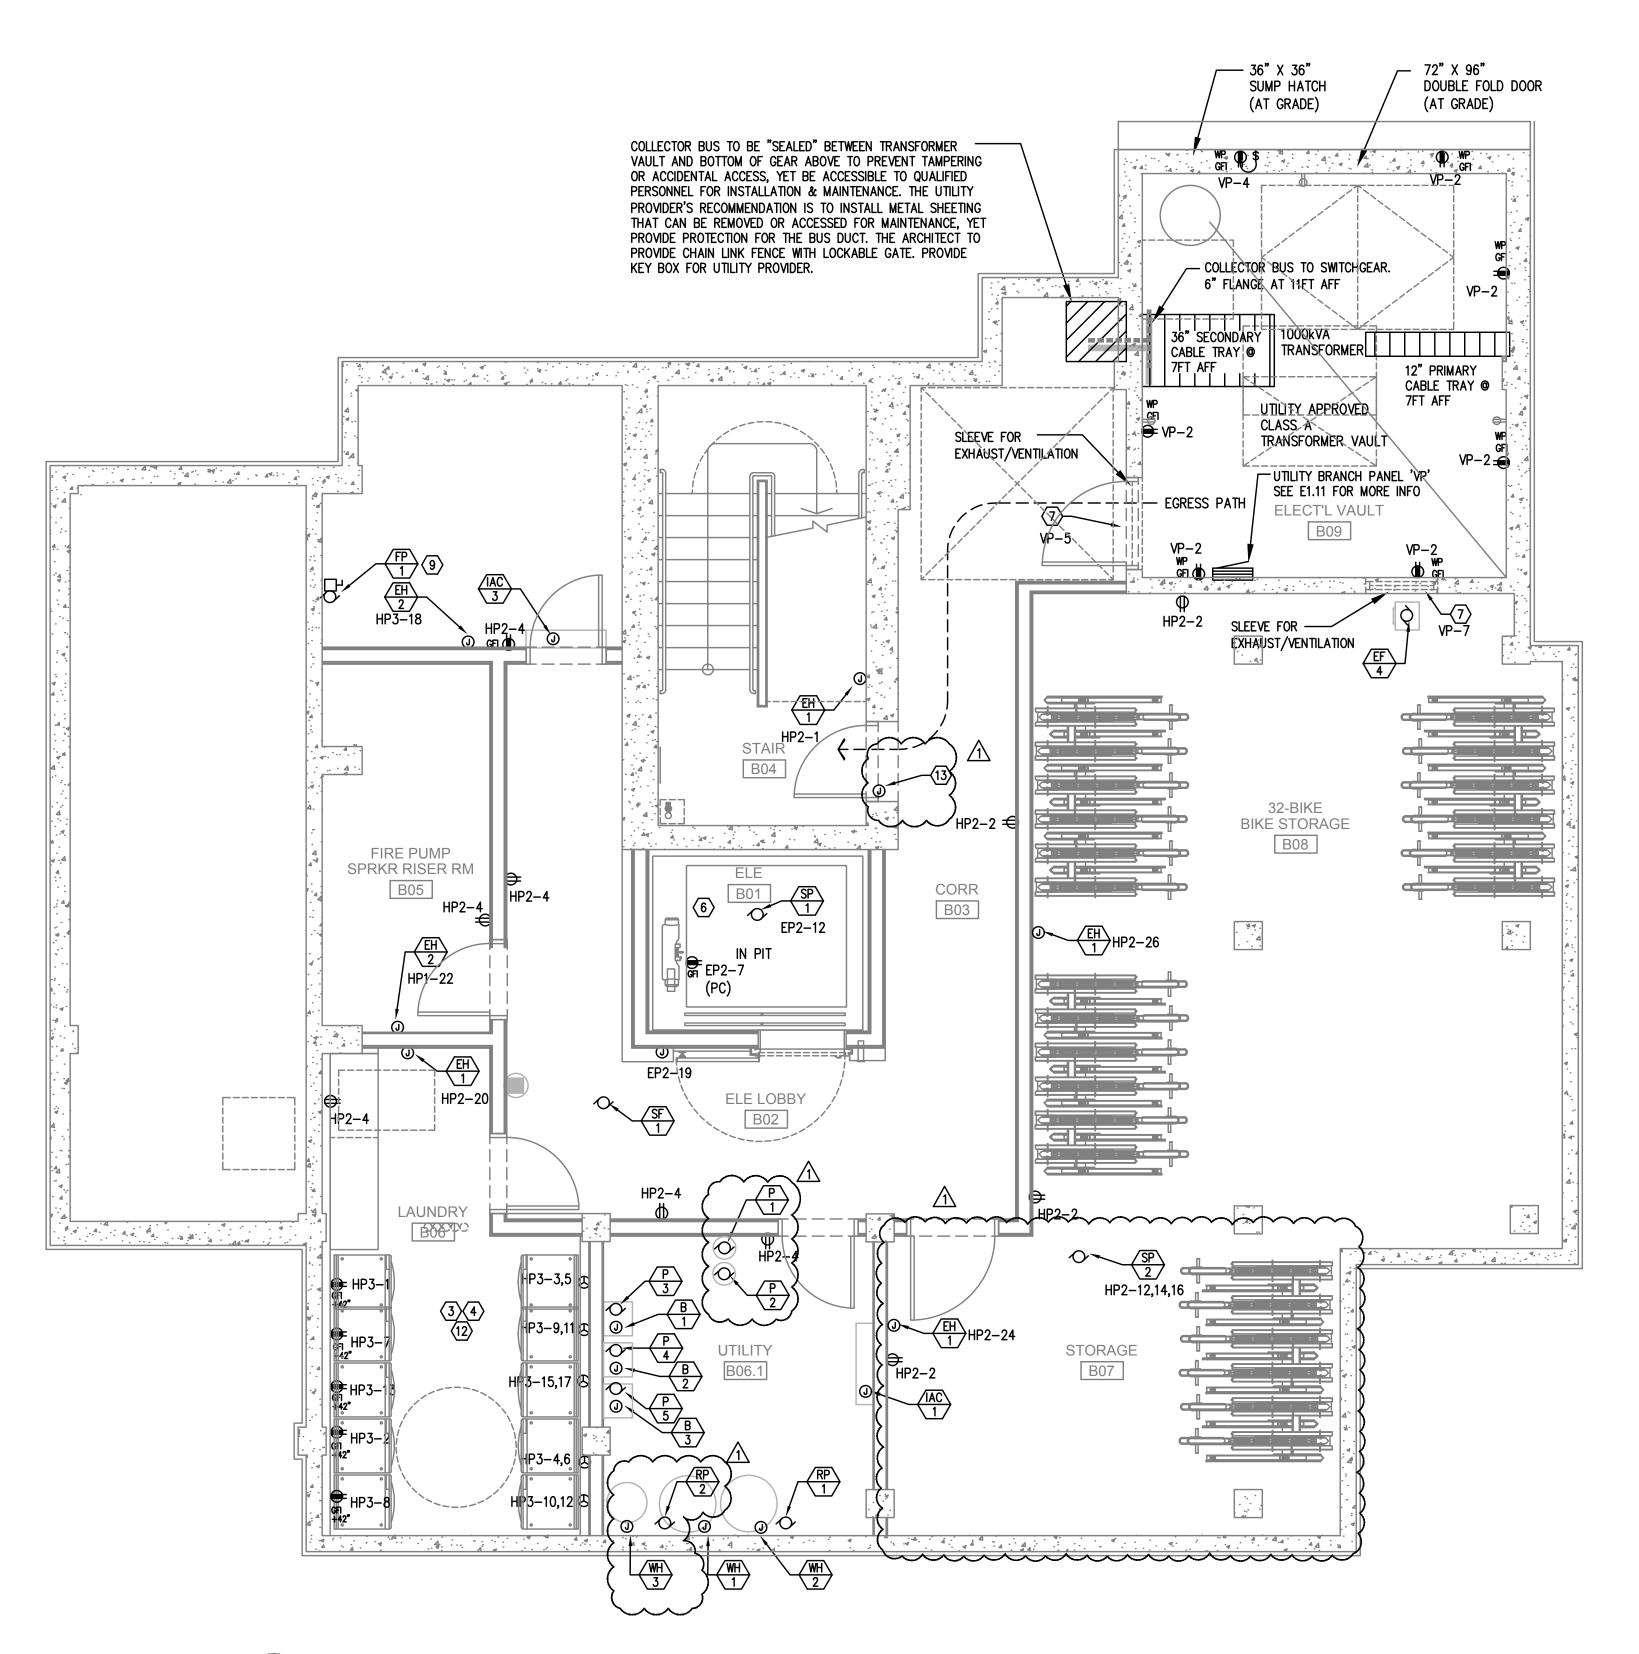



1 POWER PLAN — BASEMENT LEVEL E3.00 SCALE: 1/4" = 1'-0"

### GENERAL POWER NOTES:

- A. ELECTRICAL DRAWINGS ARE DIAGRAMMATICAL AND MAY NOT ACCURATELY REFLECT ACTUAL CONSTRUCTION CONDITIONS. THE ELECTRICAL CONTRACTOR SHALL BE RESPONSIBLE FOR COORDINATING THE INSTALLATION OF ALL ELECTRICAL EQUIPMENT, WITH ALL TRADES PRIOR TO AND DURING CONSTRUCTION.
- B. WORK SHALL BE IN ACCORDANCE WITH ALL APPLICABLE LOCAL, STATE AND NATIONAL CODES.
- C. ELECTRICAL CONTRACTOR TO PROVIDE THERMOSTATS NOT SUPPLIED BY MECHANICAL CONTRACTOR, AS REQUIRED. CONSULT MECHANICAL PLANS FOR ADDITIONAL INFORMATION.
- D. ELECTRICAL CONTRACTOR SHALL PROVIDE INSTALLATION AND FINAL CONNECTION OF THERMOSTATS AS REQUIRED. CONSULT MECHANICAL CONTRACTOR FOR EXACT REQUIREMENTS PRIOR TO ROUGH IN.
- E. COORDINATE WITH DIVISION 23 FOR EXACT LOCATION AND POWER REQUIREMENTS OF ALL MECHANICAL EQUIPMENT PRIOR TO ROUGH IN. REFER TO SHEET E1.13 FOR MECHANICAL EQUIPMENT SCHEDULE.
- F. THE ELECTRICAL CONTRACTOR SHALL REFER TO THE ARCHITECTURAL DRAWINGS FOR ALL MOUNTING HEIGHTS AND FINISHES OF DEVICES AND FIXTURES.
- G. ELECTRICAL CONTRACTOR SHALL REFER TO THE 'T' SERIES SHEETS AND PROVIDE ROUGH IN FOR THE LOW VOLTAGE SYSTEMS/FIRE
- H. SERVICE ENTRANCE AND METERING EQUIPMENT SHOWN TO APPROXIMATE SCALE, BASED ON SIEMENS PRODUCTS. CONTRACTOR SHALL BE RESPONSIBLE FOR ENSURING THAT INSTALLED EQUIPMENT FITS THE SPACE PROVIDED AND THAT ALL REQUIRED WORKING CLEARANCES ARE PROVIDED.
- I. THE CLASS 'A' TRANSFORMER VAULT SHALL BE IN ACCORDANCE WITH NEC REQUIREMENTS AS WELL AS THOSE OF THE UTILITY PROVIDER. MAN-DOOR SHALL BE EQUIPPED WITH PANIC HARDWARE AND AN OUTWARD SWING.
- J. PROVIDE A KEY BOX AT THE TRANSFORMER ROOM DOOR PER THE UTILITY PROVIDER'S REQUIREMENTS, FOR 24/7 ACCESS.
- TENANT ELECTRICAL METERING SHALL BE SUB-METERED BY THE OWNER PER THE UTILITY PROVIDER'S REQUIREMENTS. SUB-METERING EQUIPMENT IS BASED ON SIEMENS SEM3 PRODUCTS. REFER TO SHEET E1.11 FOR ADDITIONAL INFORMATION.
- L. REFER TO 'E4' SERIES SHEETS FOR TYPICAL DWELLING UNIT POWER PLANS.
- M. PROVIDE ROUGH IN AND WIRING FOR ACCESS CONTROL. REFER TO 'T' SERIES SHEETS FOR ADDITIONAL INFORMATION.
- N. LOW VOLTAGE/COMMUNICATIONS SYSTEM DEMARCATION BOARD(S). COORDINATE LOCATIONS AND ELECTRICAL POWER REQUIREMENTS WITH THE TELECOM PLANS ('T' SERIES SHEETS) AND LOW VOLTAGE SYSTEMS INSTALLERS. PROVIDE ROUGH IN AND/OR FINAL ELECTRICAL POWER CONNECTIONS & DEVICES. REFER PANEL 'HP2' SCHEDULE ON E1.12 FOR CIRCUITS.
- O. REFER TO SHEET E1.12 FOR TYPICAL DWELLING UNIT LOAD CENTER SCHEDULE FOR CIRCUITING INFORMATION.
- P. EACH UNIT LOAD CENTER TO BE FED VIA SUB-METERING SYSTEM. REFER TO ONE-LINE DIAGRAM ON SHEET E1.11 FOR CONDUCTOR SIZE AND CABLING.

#### 

- 1. PROVIDE KEY BOX FOR PGE AT METER ROOM FOR 24/7 ACCESS.
- 2. GENERATOR EMERGENCY DISCONNECT.
- 3. LAUNDRY ROOM GFCI RECEPTACLES FOR WASHING MACHINES TO BE MOUNTED AT 42" A.F.F., OR UNLESS OTHERWISE DIRECTED BY THE ARCHITECT. LAUNDRY ROOM APPLIANCES CIRCUITED TO PANEL 'HP3'. REFER TO PANEL SCHEDULE ON SHEET E1.12.
- 4. 40A, DEDICATED 14-40R DRYER RECEPTACLE (TYPICAL). VERIFY EXACT POWER RATING REQUIRED FOR THE COMMERCIAL DRYERS PRIOR TO ORDERING. LAUNDRY ROOM APPLIANCES CIRCUITED TO PANEL 'HP3'. REFER TO PANEL SCHEDULE ON SHEET E1.12.
- EXHAUST FAN IN THIS AREA TO BE TIED INTO THE LIGHTING CIRCUIT.
- 6. CONSULT ELEVATOR PROVIDER FOR EXACT POWER REQUIREMENTS AND PROVIDE ALL ELECTRICAL WORK AS DIRECTED. VERIFY EXACT LOCATION FOR ELEVATOR EQUIPMENT WITH ARCHITECT AND COORDINATE WITH ELEVATOR INSTALLER.
- 7. SMOKE DAMPER FOR VENTILATION LOUVER. COORDINATE WITH MECHANICAL EQUIPMENT INSTALLER AND CIRCUIT AS INDICATED
- 8. PROVIDE POWER CONNECTION FOR IRRIGATION CONTROLS. COORDINATE WITH THE LANDSCAPER FOR EXACT REQUIREMENTS AND LOCATION PRIOR TO ROUGH IN.
- ONSULT FIRE SPRINKLER SYSTEM PLAN SET AND COORDINATE EXACT LOCATION AND ELECTRICAL REQUIREMENTS FOR THE BUILDING FIRE PUMP.
- 10. REFER TO THE HOUSE PANEL 'HP1' PANEL SCHEDULE FOR CORRIDOR RECEPTACLE CIRCUITS ON FLOOR 2 THROUGH 11.
- 11. REFER TO PLUMBING PLAN SHEETS FOR ADDITIONAL INFORMATION ON THE PUMP SYSTEMS IN THIS SPACE. COORDINATE WITH INSTALLER AND PROVIDE ELECTRICAL CONNECTIONS AS REQUIRED. PROVIDE CIRCUITS FROM PANEL HP2, SEE PANEL SCHEDULES.
- 12. PROVIDE ONE 20A, 120V, 1P CIRCUIT FROM PANEL HP3 FOR DRYER BOOSTER FANS. COORDINATE WITH MECHANICAL EQUIPMENT

  UNSTALLER FOR WIRING REQUIREMENTS PRIOR TO ROUGH IN.

3. PROVIDE ONE 20A, 120V, 1P CIRCUIT FROM PANEL EP2 FOR AUTOMATIC DOOR CLOSER(S), TIED TO FIRE ALARM SYSTEM. COORDINATE WITH FIRE ALARM EQUIPMENT INSTALLER FOR WIRING REQUIREMENTS PRIOR TO ROUGH IN.


STAIRWELL PRESSURIZATION FANS ARE INTERLOCKED WITH MOTORIZED SMOKE DAMPERS AND BAROMETRIC RELIEF DAMPERS. REFER TO MECHANICAL PLANS SHEETS AND COORDINATE WITH THE MECHANICAL EQUIPMENT INSTALLER FOR ADDITIONAL INFORMATION. BOTH THE PRESSURIZATION FANS AND DAMPERS ARE TO BE CIRCUITED TO THE EMERGENCY POWER SYSTEM AND VIA THE FACP. SEE PANEL EP2 FOR PROPOSED CIRCUITING.

*POWER SHALL BE MONITORED DOWN STREAM OF THE DISCONNECTS.
*PROVIDE CURRENT TRANSDUCER TO MONITOR FAN AIRFLOW (HAWKEYE 608 OR EQUAL).

### CLASS A TRANSFORMER VAULT GENERAL NOTES

- A1. VAULT ROOM DOORS SHALL BE BLAST-RATED METAL DOORS. DOORS AND VENT SHUTTERS MUST HAVE A THREE HOUR BLAST & FIRE RATING PER NFPA 450.43.
- VAULT VENTS MUST HAVE SHUTTERS THAT ARE AUTOMATICALLY CLOSED BY THE HEAT DETECTOR IN THE FIRE SUPPRESSION SYSTEM HEAT DETECTORS SHALL MEET NFPA 72 REQUIREMENTS.

- PROVIDE TWO "RATE TO RISE" HEAT DETECTORS PER THE UTILITY PROVIDER'S REQUIREMENTS. LOCATE ONE ABOVE THE TRANSFORMER A3. AND ONE OTHER WITHIN THE ROOM.
- A4. ALL OPENING, GAPS & CRACKS MUST BE SEALED WITH THREE—HOUR RATED FIRE CAULKING. CONSULT UTILITY PROVIDER FOR APPROVED PRODUCTS.
- A5. NON-METALIC SEISMIC-APPROVED CABLE TRAY WITH GALVANIZED HARDWARE SHALL BE INSTALLED IN VAULT ROOMS WITH CEILING GREATER THAN 10 FEET HIGH.
- A6. ALL MATERIALS AND PRODUCTS USED WITHIN THE CLASS A VAULT IS SUBJECT TO THE UTILITY PROVIDER'S APPROVAL.
- A7. PRIMARY SERVICE CONDUCTORS FROM THE PROPERTY LINE TO THE VAULT SHALL BE IN SCHEDULE 40 PVC PER THE UTILITY PROVIDER'S DIRECTION. ALL CONDUIT PENETRATIONS MUST BE SEALED WITH A FLEXIBLE NON—SHRINK HYDROPHOBIC GROUT TO PREVENT WATER INTRUSION.
- A8. THE CLASS A VAULT SHALL BE PROVIDED WITH BOTH EQUIPMENT AND UFER GROUNDING PER THE UTILITY PROVIDER'S REQUIREMENTS.
- A9. PROVIDE TWO DIRECT UFER GROUND CONNECTIONS TO THE BUILDING FOOTER OR SOLDIER PILING, CONNECTIONS TO BE LOCATED AT OPPOSITE CORNERS OF THE VAULT FLOOR IN ACCORDANCE WITH NEC 250.
- A10. PROVIDE A CONTINUOUS LOOP OF 250MCM BARE COPPER AROUND THE ROOM AT 24 INCHES ABOVE THE FLOOR, WITH HUBS AT 5-FOOT INTERVALS.
- A11. REFER TO E2 SERIES SHEETS FOR LIGHTING WITHIN THE VAULT ROOM.
- A12. THE ELECTRICAL CONTRACTOR SHALL CONSULT WITH THE UTILITY PROVIDER AND THE PROVIDER'S REQUIREMENTS FOR CLASS A TRANSFORMER VAULTS PRIOR TO THE START OF ANY WORK. THE UTILITY PROVIDER IS THE AUTHORITY REGARDING ALL ASPECS OF THE VAULT ROOM

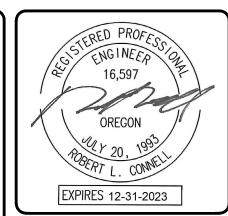

REGON

PARK AVE.

BASEMENT


TLAND
OWER PLA



Consulting Engineers 2007 S.E. Ash St. Portland, OR 97214 PHN: (503) 234-0548 FAX: (503) 234-0677 WWW.MFIA-ENG.COM

SHEET

E3.00

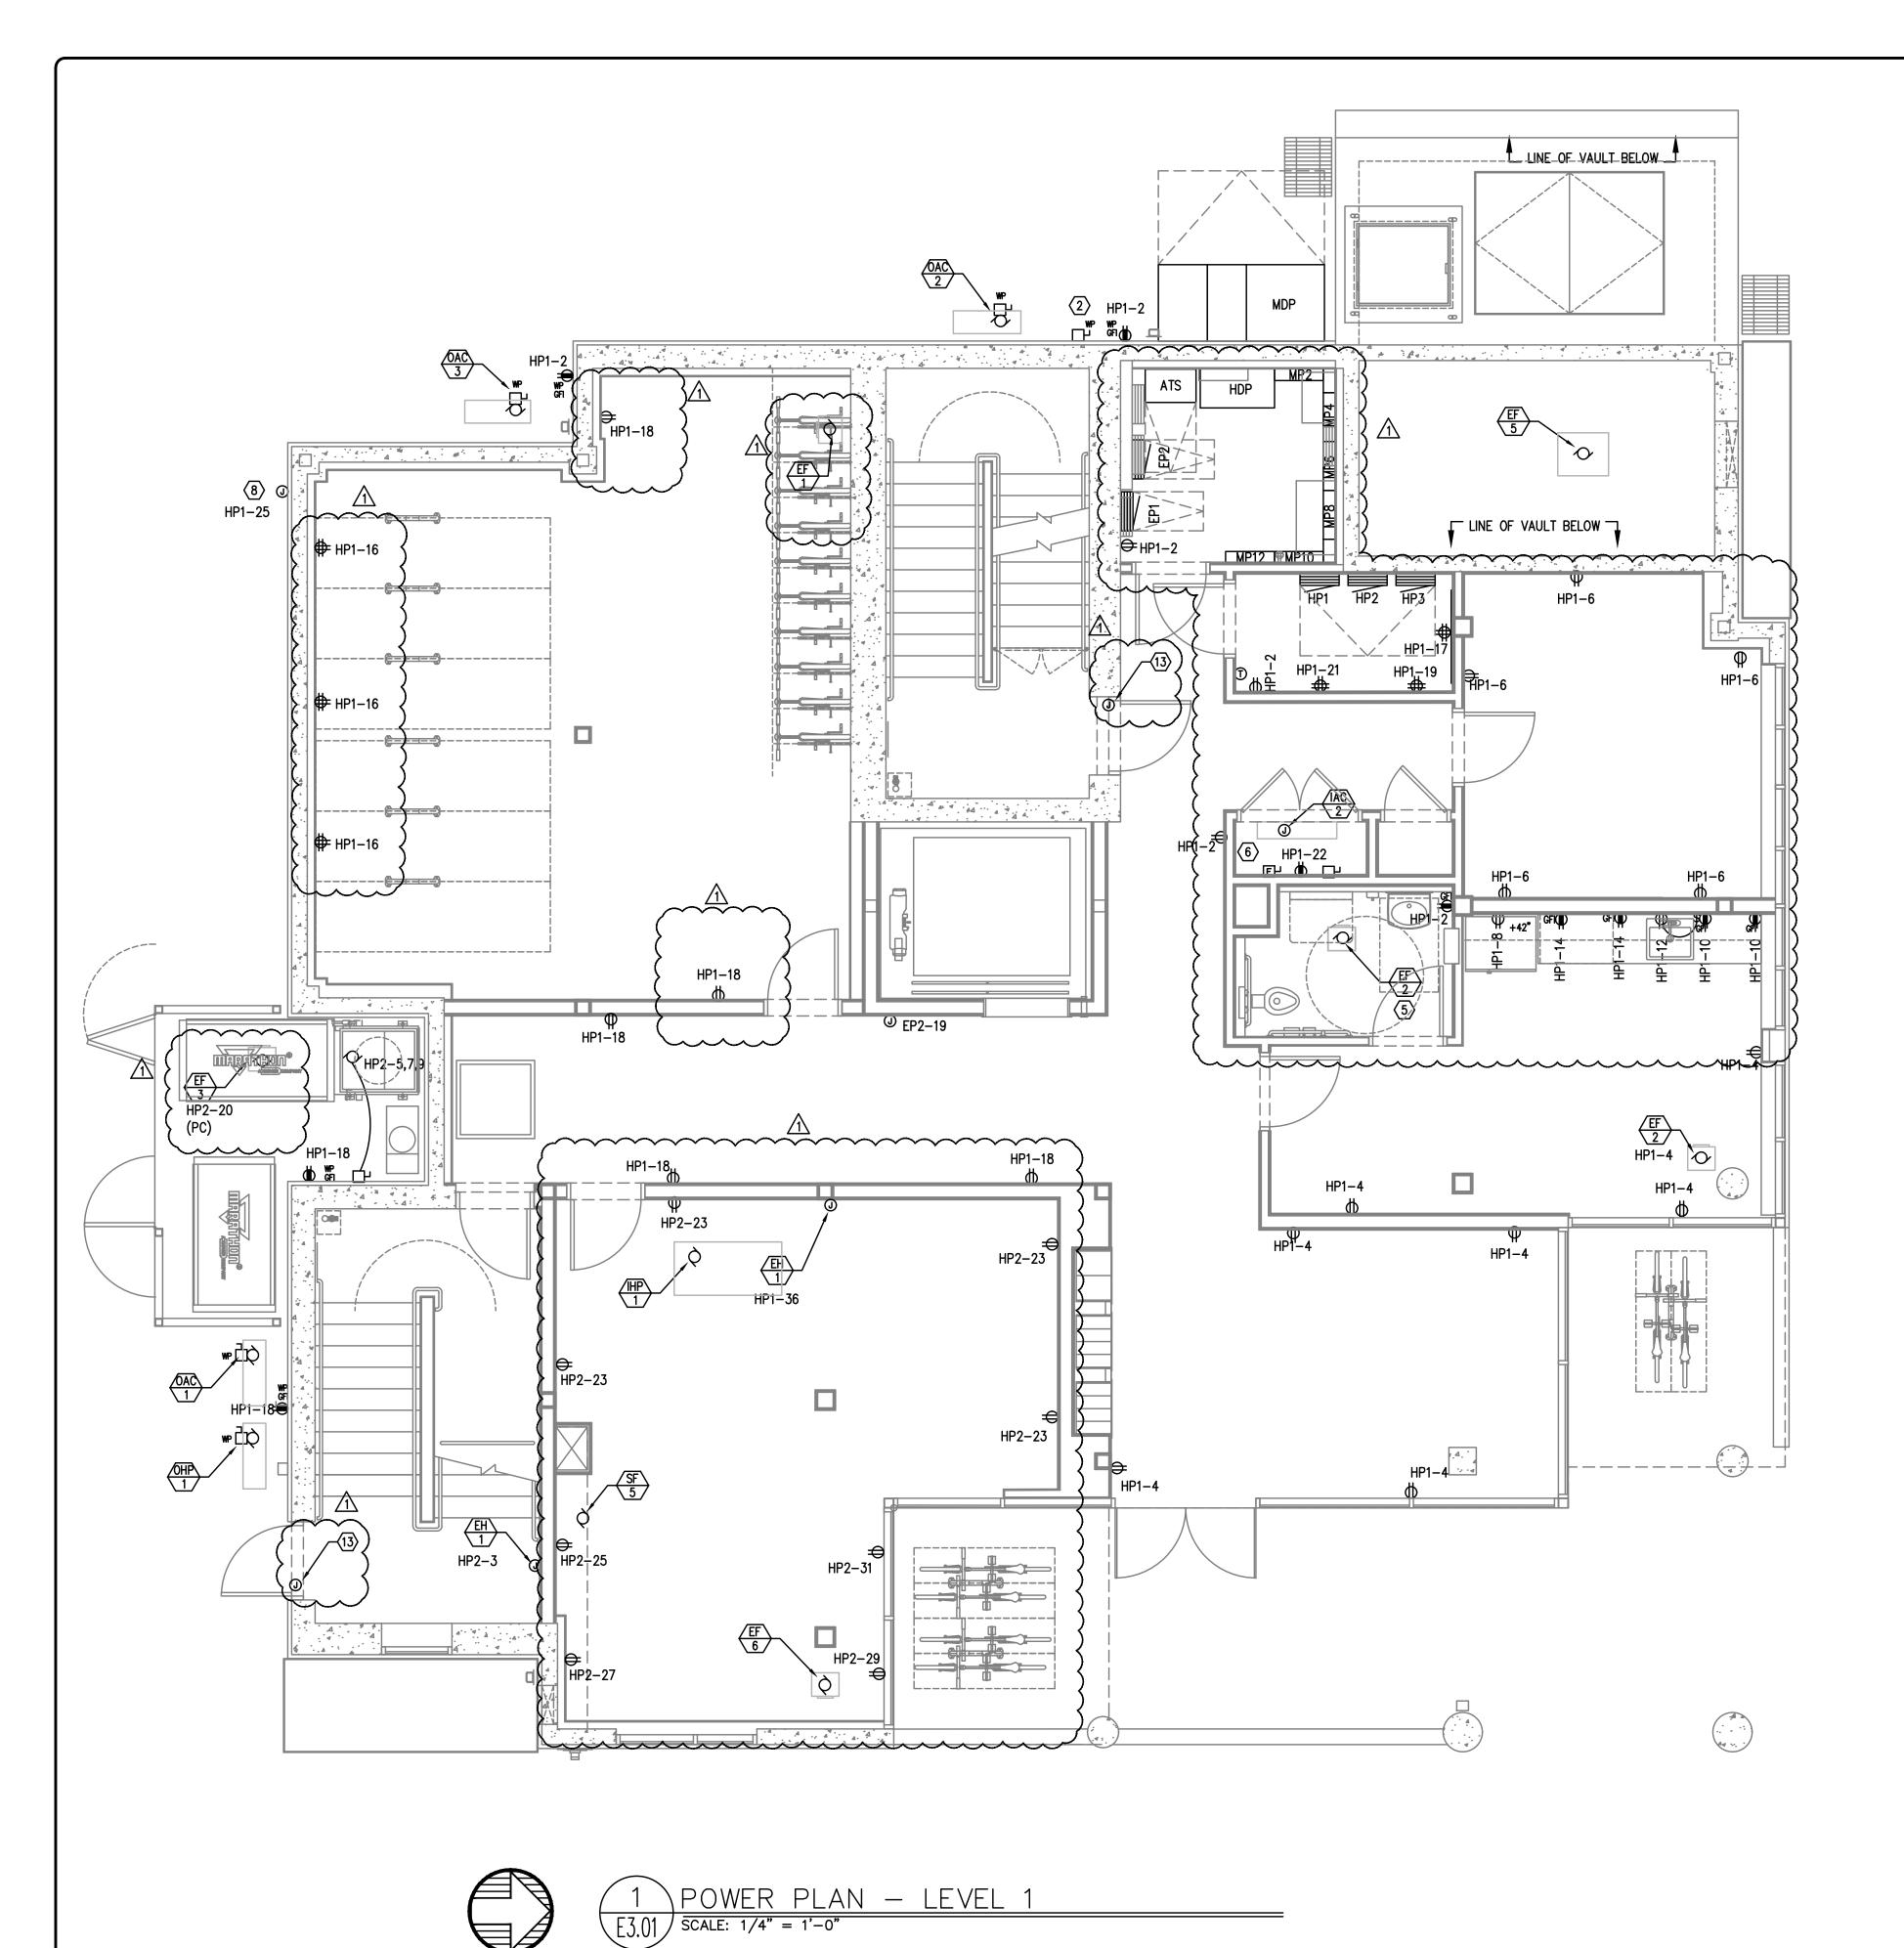

- A. ELECTRICAL DRAWINGS ARE DIAGRAMMATICAL AND MAY NOT ACCURATELY REFLECT ACTUAL CONSTRUCTION CONDITIONS. THE ELECTRICAL CONTRACTOR SHALL BE RESPONSIBLE FOR COORDINATING THE INSTALLATION OF ALL ELECTRICAL EQUIPMENT, WITH ALL TRADES PRIOR TO AND DURING CONSTRUCTION.
- B. WORK SHALL BE IN ACCORDANCE WITH ALL APPLICABLE LOCAL, STATE AND NATIONAL CODES.
- C. ELECTRICAL CONTRACTOR TO PROVIDE THERMOSTATS NOT SUPPLIED BY MECHANICAL CONTRACTOR, AS REQUIRED. CONSULT MECHANICAL PLANS FOR ADDITIONAL INFORMATION.
- D. ELECTRICAL CONTRACTOR SHALL PROVIDE INSTALLATION AND FINAL CONNECTION OF THERMOSTATS AS REQUIRED. CONSULT MECHANICAL CONTRACTOR FOR EXACT REQUIREMENTS PRIOR TO ROUGH IN.
- . COORDINATE WITH DIVISION 23 FOR EXACT LOCATION AND POWER REQUIREMENTS OF ALL MECHANICAL EQUIPMENT PRIOR TO ROUGH IN. REFER TO SHEET E1.13 FOR MECHANICAL EQUIPMENT SCHEDULE.
- F. THE ELECTRICAL CONTRACTOR SHALL REFER TO THE ARCHITECTURAL DRAWINGS FOR ALL MOUNTING HEIGHTS AND FINISHES OF DEVICES AND FIXTURES.
- G. ELECTRICAL CONTRACTOR SHALL REFER TO THE 'T' SERIES SHEETS AND PROVIDE ROUGH IN FOR THE LOW VOLTAGE SYSTEMS/FIRE
- H. SERVICE ENTRANCE AND METERING EQUIPMENT SHOWN TO APPROXIMATE SCALE, BASED ON SIEMENS PRODUCTS. CONTRACTOR SHALL BE RESPONSIBLE FOR ENSURING THAT INSTALLED EQUIPMENT FITS THE SPACE PROVIDED AND THAT ALL REQUIRED WORKING CLEARANCES ARE PROVIDED.
- 1. THE CLASS 'A' TRANSFORMER VAULT SHALL BE IN ACCORDANCE WITH NEC REQUIREMENTS AS WELL AS THOSE OF THE UTILITY PROVIDER. MAN-DOOR SHALL BE EQUIPPED WITH PANIC HARDWARE AND AN OUTWARD SWING.
- J. PROVIDE A KEY BOX AT THE TRANSFORMER ROOM DOOR PER THE UTILITY PROVIDER'S REQUIREMENTS, FOR 24/7 ACCESS.
- K. TENANT ELECTRICAL METERING SHALL BE SUB-METERED BY THE OWNER PER THE UTILITY PROVIDER'S REQUIREMENTS.
  SUB-METERING EQUIPMENT IS BASED ON SIEMENS SEM3 PRODUCTS. REFER TO SHEET E1.11 FOR ADDITIONAL INFORMATION.
- L. REFER TO 'E4' SERIES SHEETS FOR TYPICAL DWELLING UNIT POWER PLANS.
- M. PROVIDE ROUGH IN AND WIRING FOR ACCESS CONTROL. REFER TO 'T' SERIES SHEETS FOR ADDITIONAL INFORMATION.
- N. LOW VOLTAGE/COMMUNICATIONS SYSTEM DEMARCATION BOARD(S). COORDINATE LOCATIONS AND ELECTRICAL POWER REQUIREMENTS WITH THE TELECOM PLANS ('T' SERIES SHEETS) AND LOW VOLTAGE SYSTEMS INSTALLERS. PROVIDE ROUGH IN AND/OR FINAL ELECTRICAL POWER CONNECTIONS & DEVICES. REFER PANEL 'HP2' SCHEDULE ON E1.12 FOR CIRCUITS.
- O. REFER TO SHEET E1.12 FOR TYPICAL DWELLING UNIT LOAD CENTER SCHEDULE FOR CIRCUITING INFORMATION.
- P. EACH UNIT LOAD CENTER TO BE FED VIA SUB-METERING SYSTEM. REFER TO ONE-LINE DIAGRAM ON SHEET E1.11 FOR CONDUCTOR SIZE AND CABLING.

### 

- 1. PROVIDE KEY BOX FOR PGE AT METER ROOM FOR 24/7 ACCESS.
- GENERATOR EMERGENCY DISCONNECT.
- 3. LAUNDRY ROOM GFCI RECEPTACLES FOR WASHING MACHINES TO BE MOUNTED AT 42" A.F.F., OR UNLESS OTHERWISE DIRECTED BY THE ARCHITECT. LAUNDRY ROOM APPLIANCES CIRCUITED TO PANEL 'HP3'. REFER TO PANEL SCHEDULE ON SHEET E1.12.
- 4. 40A, DEDICATED 14-40R DRYER RECEPTACLE (TYPICAL). VERIFY EXACT POWER RATING REQUIRED FOR THE COMMERCIAL DRYERS PRIOR TO ORDERING. LAUNDRY ROOM APPLIANCES CIRCUITED TO PANEL 'HP3'. REFER TO PANEL SCHEDULE ON SHEET E1.12.
- EXHAUST FAN IN THIS AREA TO BE TIED INTO THE LIGHTING CIRCUIT.
- CONSULT ELEVATOR PROVIDER FOR EXACT POWER REQUIREMENTS AND PROVIDE ALL ELECTRICAL WORK AS DIRECTED. VERIFY EXACT LOCATION FOR ELEVATOR EQUIPMENT WITH ARCHITECT AND COORDINATE WITH ELEVATOR INSTALLER.
- SMOKE DAMPER FOR VENTILATION LOUVER. COORDINATE WITH MECHANICAL EQUIPMENT INSTALLER AND CIRCUIT AS INDICATED
- PROVIDE POWER CONNECTION FOR IRRIGATION CONTROLS. COORDINATE WITH THE LANDSCAPER FOR EXACT REQUIREMENTS AND LOCATION PRIOR TO ROUGH IN.
- CONSULT FIRE SPRINKLER SYSTEM PLAN SET AND COORDINATE EXACT LOCATION AND ELECTRICAL REQUIREMENTS FOR THE BUILDING FIRE PUMP.
- ). REFER TO THE HOUSE PANEL 'HP1' PANEL SCHEDULE FOR CORRIDOR RECEPTACLE CIRCUITS ON FLOOR 2 THROUGH 11.
- 11. REFER TO PLUMBING PLAN SHEETS FOR ADDITIONAL INFORMATION ON THE PUMP SYSTEMS IN THIS SPACE. COORDINATE WITH
- INSTALLER AND PROVIDE ELECTRICAL CONNECTIONS AS REQUIRED. PROVIDE CIRCUITS FROM PANEL HP2, SEE PANEL SCHEDULES.

  12. PROVIDE ONE 20A, 120V, 1P CIRCUIT FROM PANEL HP3 FOR DRYER BOOSTER FANS. COORDINATE WITH MECHANICAL EQUIPMENT
- INSTALLER FOR WIRING REQUIREMENTS PRIOR TO ROUGH IN.

  13. PROVIDE ONE 20A, 120V, 1P CIRCUIT FROM PANEL EP2 FOR AUTOMATIC DOOR CLOSER(S), TIED TO FIRE ALARM SYSTEM.

  COORDINATE WITH FIRE ALARM EQUIPMENT INSTALLER FOR WIRING REQUIREMENTS PRIOR TO ROUGH IN.
  - STAIRWELL PRESSURIZATION FANS ARE INTERLOCKED WITH MOTORIZED SMOKE DAMPERS AND BAROMETRIC RELIEF DAMPERS. REFER TO MECHANICAL PLANS SHEETS AND COORDINATE WITH THE MECHANICAL EQUIPMENT INSTALLER FOR ADDITIONAL INFORMATION.


    BOTH THE PRESSURIZATION FANS AND DAMPERS ARE TO BE CIRCUITED TO THE EMERGENCY POWER SYSTEM AND VIA THE FACP. SEE PANEL EP2 FOR PROPOSED CIRCUITING.

______

*POWER SHALL BE MONITORED DOWN STREAM OF THE DISCONNECTS.

*PROVIDE CURRENT TRANSDUCER TO MONITOR FAN AIRFLOW (HAWKEYE 608 OR EQUAL).



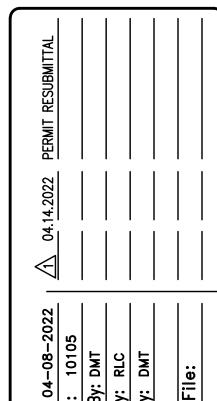

OREGON

RYSTADT 2057 SW PARK AVE.

TLAND


 $\searrow$ 



Consulting Engineers 2007 S.E. Ash St. Portland, OR 97214 PHN: (503) 234-0548 FAX: (503) 234-0677 WWW.MFIA-ENG.COM

SHEET

E3.01

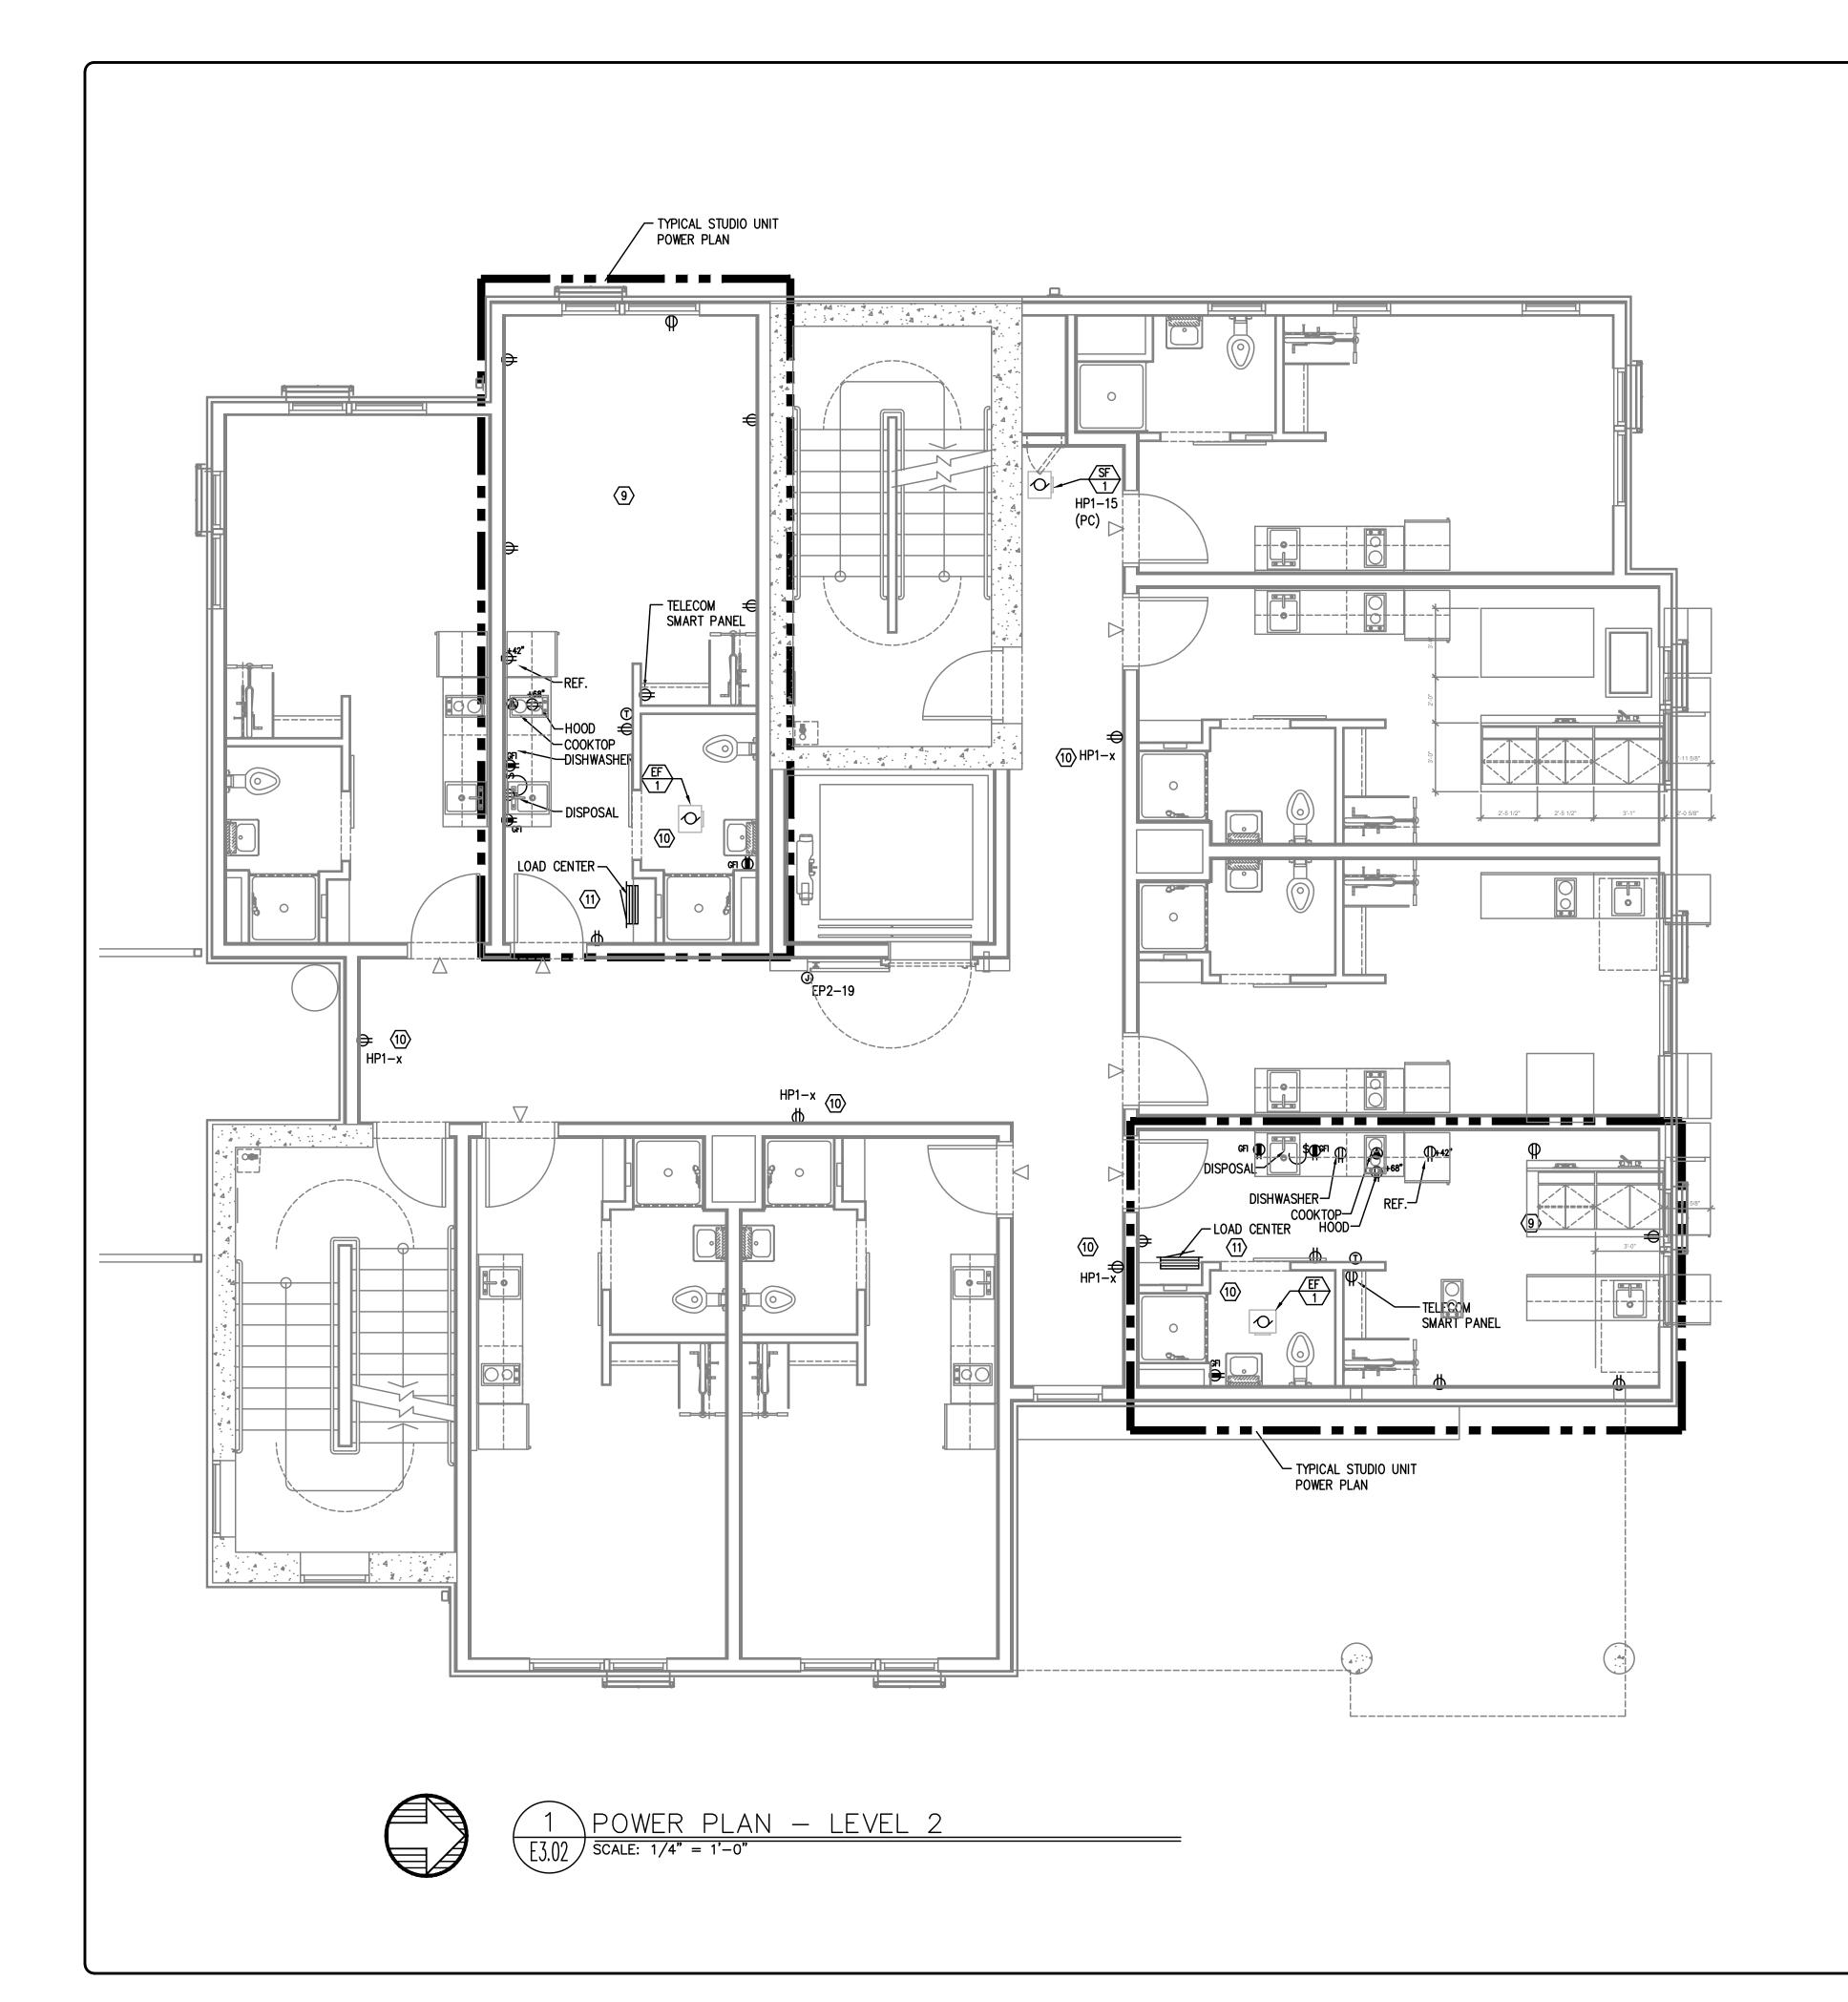


- A. ELECTRICAL DRAWINGS ARE DIAGRAMMATICAL AND MAY NOT ACCURATELY REFLECT ACTUAL CONSTRUCTION CONDITIONS. THE ELECTRICAL CONTRACTOR SHALL BE RESPONSIBLE FOR COORDINATING THE INSTALLATION OF ALL ELECTRICAL EQUIPMENT, WITH ALL TRADES PRIOR TO AND DURING CONSTRUCTION.
- B. WORK SHALL BE IN ACCORDANCE WITH ALL APPLICABLE LOCAL, STATE AND NATIONAL CODES.
- ELECTRICAL CONTRACTOR TO PROVIDE THERMOSTATS NOT SUPPLIED BY MECHANICAL CONTRACTOR, AS REQUIRED. CONSULT MECHANICAL PLANS FOR ADDITIONAL INFORMATION.
- D. ELECTRICAL CONTRACTOR SHALL PROVIDE INSTALLATION AND FINAL CONNECTION OF THERMOSTATS AS REQUIRED. CONSULT MECHANICAL CONTRACTOR FOR EXACT REQUIREMENTS PRIOR TO ROUGH IN.
- COORDINATE WITH DIVISION 23 FOR EXACT LOCATION AND POWER REQUIREMENTS OF ALL MECHANICAL EQUIPMENT PRIOR TO ROUGH IN. REFER TO SHEET E1.13 FOR MECHANICAL EQUIPMENT SCHEDULE.
- F. THE ELECTRICAL CONTRACTOR SHALL REFER TO THE ARCHITECTURAL DRAWINGS FOR ALL MOUNTING HEIGHTS AND FINISHES OF DEVICES AND FIXTURES.
- G. ELECTRICAL CONTRACTOR SHALL REFER TO THE 'T' SERIES SHEETS AND PROVIDE ROUGH IN FOR THE LOW VOLTAGE SYSTEMS/FIRE
- H. SERVICE ENTRANCE AND METERING EQUIPMENT SHOWN TO APPROXIMATE SCALE, BASED ON SIEMENS PRODUCTS. CONTRACTOR SHALL BE RESPONSIBLE FOR ENSURING THAT INSTALLED EQUIPMENT FITS THE SPACE PROVIDED AND THAT ALL REQUIRED WORKING CLEARANCES ARE PROVIDED.
- 1. THE CLASS 'A' TRANSFORMER VAULT SHALL BE IN ACCORDANCE WITH NEC REQUIREMENTS AS WELL AS THOSE OF THE UTILITY PROVIDER. MAN-DOOR SHALL BE EQUIPPED WITH PANIC HARDWARE AND AN OUTWARD SWING.
- J. PROVIDE A KEY BOX AT THE TRANSFORMER ROOM DOOR PER THE UTILITY PROVIDER'S REQUIREMENTS, FOR 24/7 ACCESS.
- TENANT ELECTRICAL METERING SHALL BE SUB-METERED BY THE OWNER PER THE UTILITY PROVIDER'S REQUIREMENTS. SUB-METERING EQUIPMENT IS BASED ON SIEMENS SEM3 PRODUCTS. REFER TO SHEET E1.11 FOR ADDITIONAL INFORMATION.
- L. REFER TO 'E4' SERIES SHEETS FOR TYPICAL DWELLING UNIT POWER PLANS.
- M. PROVIDE ROUGH IN AND WIRING FOR ACCESS CONTROL. REFER TO 'T' SERIES SHEETS FOR ADDITIONAL INFORMATION.
- N. LOW VOLTAGE/COMMUNICATIONS SYSTEM DEMARCATION BOARD(S). COORDINATE LOCATIONS AND ELECTRICAL POWER REQUIREMENTS WITH THE TELECOM PLANS ('T' SERIES SHEETS) AND LOW VOLTAGE SYSTEMS INSTALLERS. PROVIDE ROUGH IN AND/OR FINAL ELECTRICAL POWER CONNECTIONS & DEVICES. REFER PANEL 'HP2' SCHEDULE ON E1.12 FOR CIRCUITS.
- O. REFER TO SHEET E1.12 FOR TYPICAL DWELLING UNIT LOAD CENTER SCHEDULE FOR CIRCUITING INFORMATION.
- P. EACH UNIT LOAD CENTER TO BE FED VIA SUB-METERING SYSTEM. REFER TO ONE-LINE DIAGRAM ON SHEET E1.11 FOR CONDUCTOR SIZE AND CABLING.


### 

- 1. PROVIDE KEY BOX FOR PGE AT METER ROOM FOR 24/7 ACCESS.
- GENERATOR EMERGENCY DISCONNECT.
- 3. LAUNDRY ROOM GFCI RECEPTACLES FOR WASHING MACHINES TO BE MOUNTED AT 42" A.F.F., OR UNLESS OTHERWISE DIRECTED BY THE ARCHITECT. LAUNDRY ROOM APPLIANCES CIRCUITED TO PANEL 'HP3'. REFER TO PANEL SCHEDULE ON SHEET E1.12.
- 4. 40A, DEDICATED 14-40R DRYER RECEPTACLE (TYPICAL). VERIFY EXACT POWER RATING REQUIRED FOR THE COMMERCIAL DRYERS PRIOR TO ORDERING. LAUNDRY ROOM APPLIANCES CIRCUITED TO PANEL 'HP3'. REFER TO PANEL SCHEDULE ON SHEET E1.12.
- EXHAUST FAN IN THIS AREA TO BE TIED INTO THE LIGHTING CIRCUIT.
- 6. CONSULT ELEVATOR PROVIDER FOR EXACT POWER REQUIREMENTS AND PROVIDE ALL ELECTRICAL WORK AS DIRECTED. VERIFY EXACT LOCATION FOR ELEVATOR EQUIPMENT WITH ARCHITECT AND COORDINATE WITH ELEVATOR INSTALLER.
- 7. SMOKE DAMPER FOR VENTILATION LOUVER. COORDINATE WITH MECHANICAL EQUIPMENT INSTALLER AND CIRCUIT AS INDICATED
- 8. PROVIDE POWER CONNECTION FOR IRRIGATION CONTROLS. COORDINATE WITH THE LANDSCAPER FOR EXACT REQUIREMENTS AND LOCATION PRIOR TO ROUGH IN.
- ONSULT FIRE SPRINKLER SYSTEM PLAN SET AND COORDINATE EXACT LOCATION AND ELECTRICAL REQUIREMENTS FOR THE
- REFER TO THE HOUSE PANEL 'HP1' PANEL SCHEDULE FOR CORRIDOR RECEPTACLE CIRCUITS ON FLOOR 2 THROUGH 11.
- 11. REFER TO PLUMBING PLAN SHEETS FOR ADDITIONAL INFORMATION ON THE PUMP SYSTEMS IN THIS SPACE. COORDINATE WITH INSTALLER AND PROVIDE ELECTRICAL CONNECTIONS AS REQUIRED. PROVIDE CIRCUITS FROM PANEL HP2, SEE PANEL SCHEDULES.
- 12. PROVIDE ONE 20A, 120V, 1P CIRCUIT FROM PANEL HP3 FOR DRYER BOOSTER FANS. COORDINATE WITH MECHANICAL EQUIPMENT
- 13. PROVIDE ONE 20A, 120V, 1P CIRCUIT FROM PANEL EP2 FOR AUTOMATIC DOOR CLOSER(S), TIED TO FIRE ALARM SYSTEM.
  COORDINATE WITH FIRE ALARM EQUIPMENT INSTALLER FOR WIRING REQUIREMENTS PRIOR TO ROUGH IN.
- 14. STAIRWELL PRESSURIZATION FANS ARE INTERLOCKED WITH MOTORIZED SMOKE DAMPERS AND BAROMETRIC RELIEF DAMPERS. REFER TO MECHANICAL PLANS SHEETS AND COORDINATE WITH THE MECHANICAL EQUIPMENT INSTALLER FOR ADDITIONAL INFORMATION. BOTH THE PRESSURIZATION FANS AND DAMPERS ARE TO BE CIRCUITED TO THE EMERGENCY POWER SYSTEM AND VIA THE FACP. SEE PANEL EP2 FOR PROPOSED CIRCUITING.

*POWER SHALL BE MONITORED DOWN STREAM OF THE DISCONNECTS.

*PROVIDE CURRENT TRANSDUCER TO MONITOR FAN AIRFLOW (HAWKEYE 608 OR EQUAL).

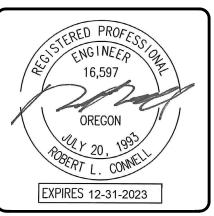

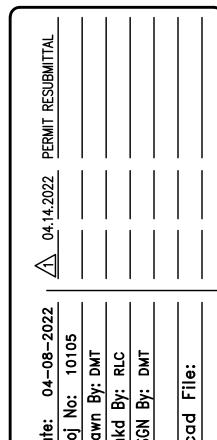

OREGON FLOOF

0

RYSTADT SW PARK AVE.


AND OWER PL

M FI

Consulting Engineers 2007 S.E. Ash St. Portland, OR 97214 PHN: (503) 234-0548 FAX: (503) 234-0677 WWW.MFIA-ENG.COM

SHEET

E3.02

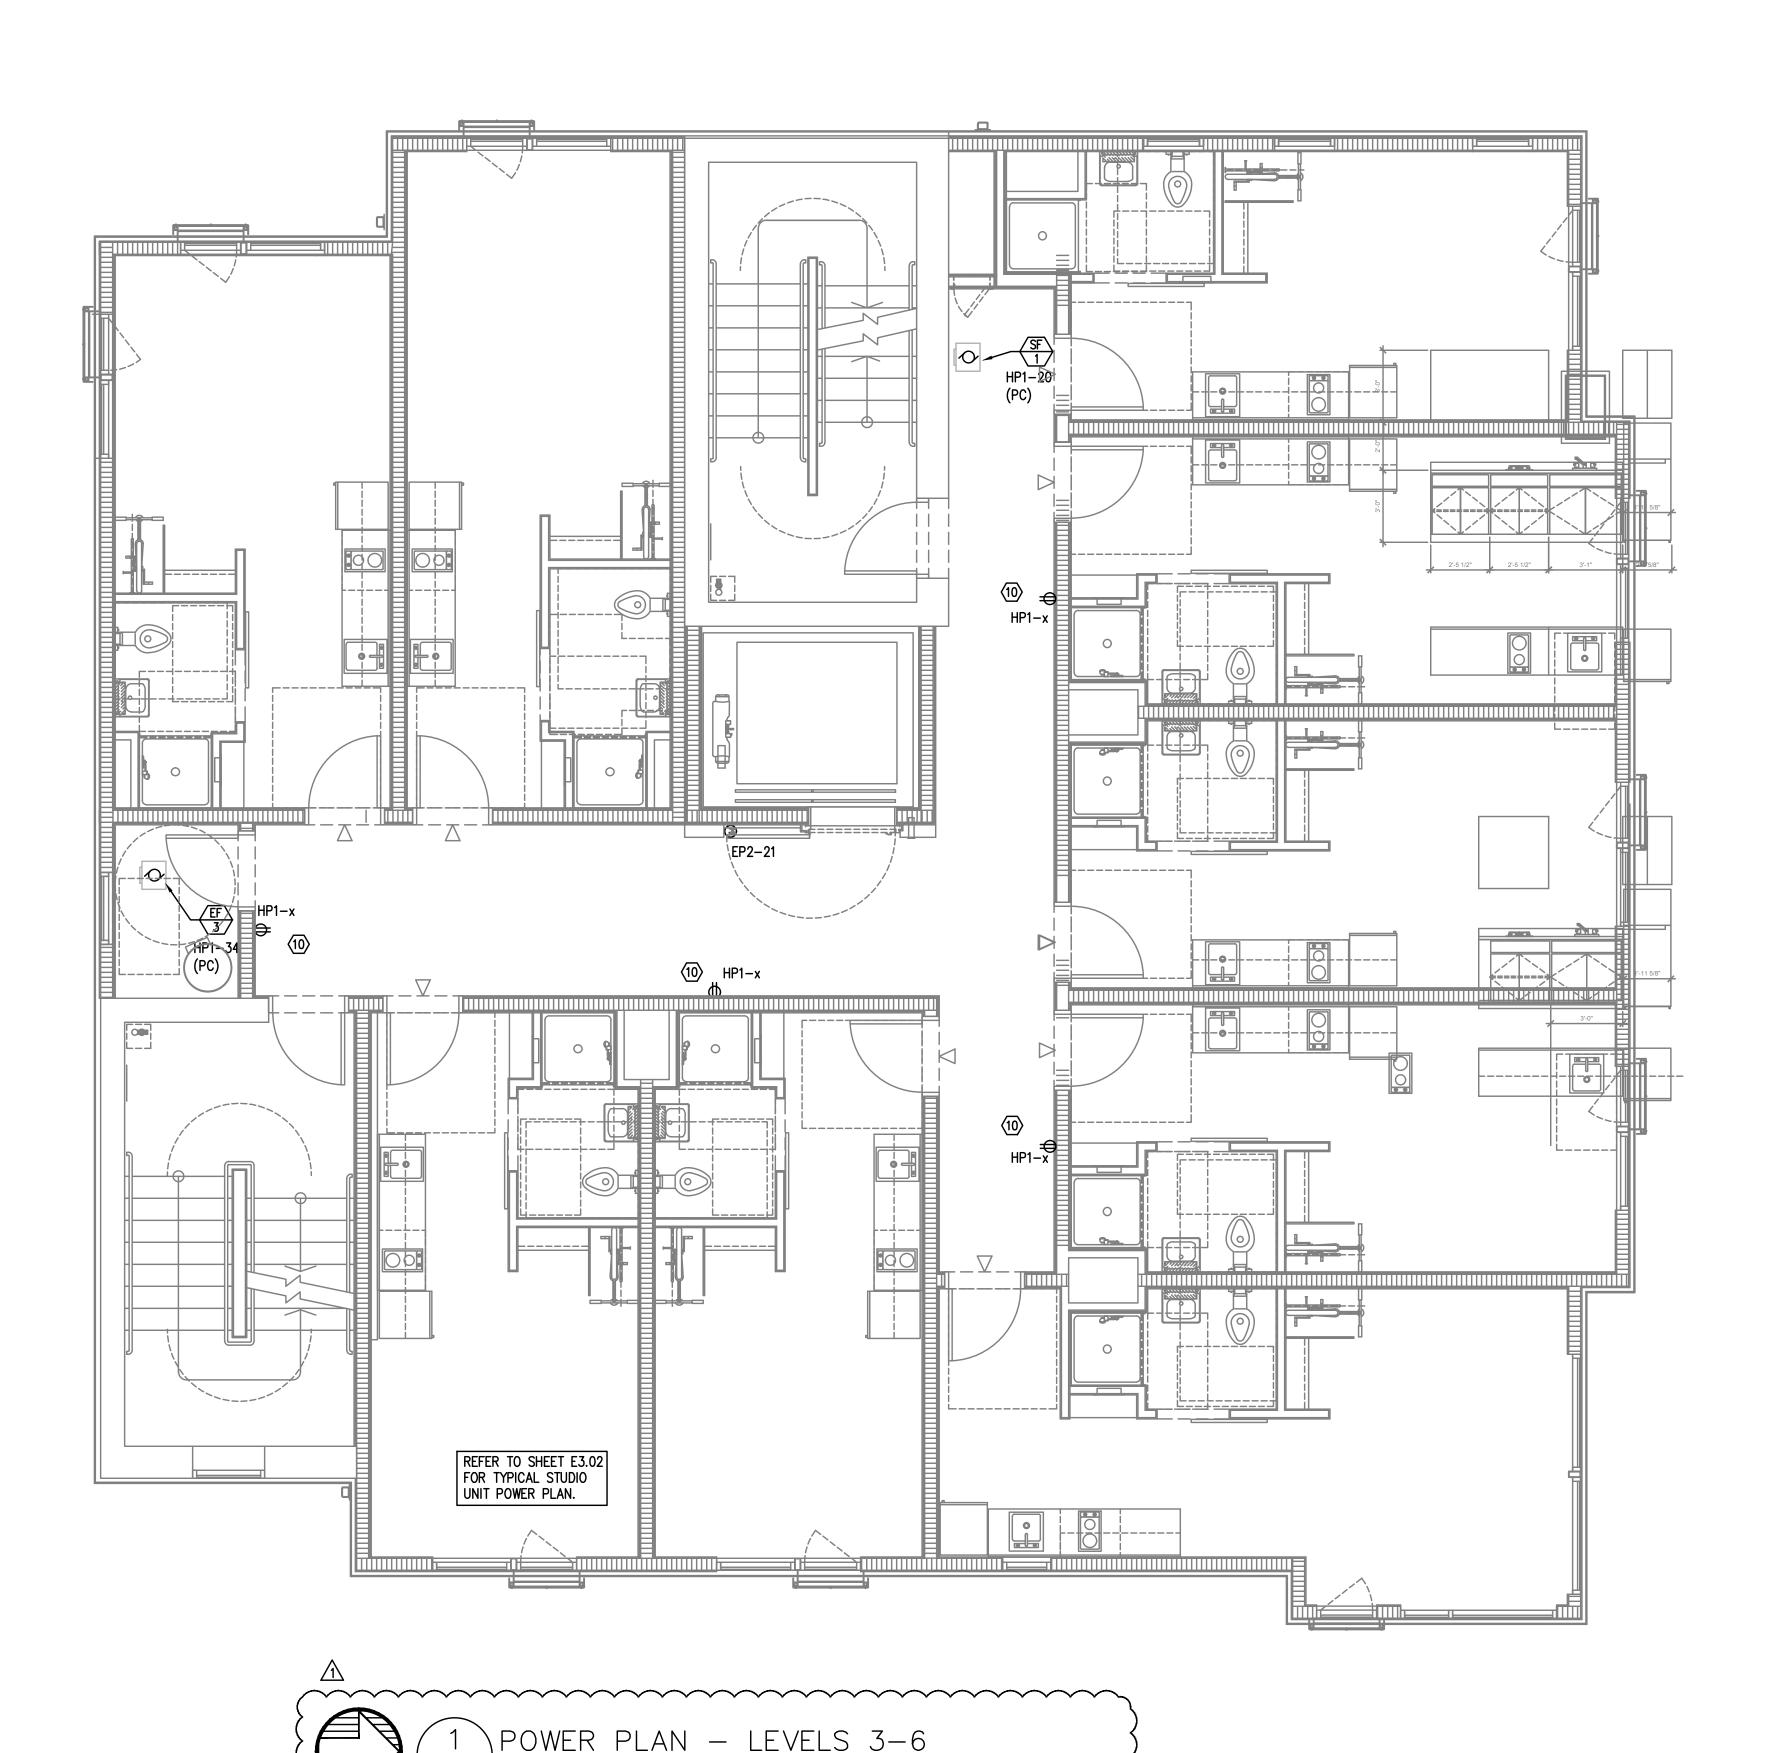

_____

#### GENERAL POWER NOTES:

- A. ELECTRICAL DRAWINGS ARE DIAGRAMMATICAL AND MAY NOT ACCURATELY REFLECT ACTUAL CONSTRUCTION CONDITIONS. THE ELECTRICAL CONTRACTOR SHALL BE RESPONSIBLE FOR COORDINATING THE INSTALLATION OF ALL ELECTRICAL EQUIPMENT, WITH ALL TRADES PRIOR TO AND DURING CONSTRUCTION.
- B. WORK SHALL BE IN ACCORDANCE WITH ALL APPLICABLE LOCAL, STATE AND NATIONAL CODES.
- ELECTRICAL CONTRACTOR TO PROVIDE THERMOSTATS NOT SUPPLIED BY MECHANICAL CONTRACTOR, AS REQUIRED. CONSULT MECHANICAL PLANS FOR ADDITIONAL INFORMATION.
- D. ELECTRICAL CONTRACTOR SHALL PROVIDE INSTALLATION AND FINAL CONNECTION OF THERMOSTATS AS REQUIRED. CONSULT MECHANICAL CONTRACTOR FOR EXACT REQUIREMENTS PRIOR TO ROUGH IN.
- E. COORDINATE WITH DIVISION 23 FOR EXACT LOCATION AND POWER REQUIREMENTS OF ALL MECHANICAL EQUIPMENT PRIOR TO ROUGH IN. REFER TO SHEET E1.13 FOR MECHANICAL EQUIPMENT SCHEDULE.
- F. THE ELECTRICAL CONTRACTOR SHALL REFER TO THE ARCHITECTURAL DRAWINGS FOR ALL MOUNTING HEIGHTS AND FINISHES OF DEVICES AND FIXTURES.
- G. ELECTRICAL CONTRACTOR SHALL REFER TO THE 'T' SERIES SHEETS AND PROVIDE ROUGH IN FOR THE LOW VOLTAGE SYSTEMS/FIRE ALARM INSTALLER.
- H. SERVICE ENTRANCE AND METERING EQUIPMENT SHOWN TO APPROXIMATE SCALE, BASED ON SIEMENS PRODUCTS. CONTRACTOR SHALL BE RESPONSIBLE FOR ENSURING THAT INSTALLED EQUIPMENT FITS THE SPACE PROVIDED AND THAT ALL REQUIRED WORKING CLEARANCES ARE PROVIDED.
- 1. THE CLASS 'A' TRANSFORMER VAULT SHALL BE IN ACCORDANCE WITH NEC REQUIREMENTS AS WELL AS THOSE OF THE UTILITY PROVIDER. MAN—DOOR SHALL BE EQUIPPED WITH PANIC HARDWARE AND AN OUTWARD SWING.
- J. PROVIDE A KEY BOX AT THE TRANSFORMER ROOM DOOR PER THE UTILITY PROVIDER'S REQUIREMENTS, FOR 24/7 ACCESS.
- K. TENANT ELECTRICAL METERING SHALL BE SUB-METERED BY THE OWNER PER THE UTILITY PROVIDER'S REQUIREMENTS. SUB-METERING EQUIPMENT IS BASED ON SIEMENS SEM3 PRODUCTS. REFER TO SHEET E1.11 FOR ADDITIONAL INFORMATION.
- L. REFER TO 'E4' SERIES SHEETS FOR TYPICAL DWELLING UNIT POWER PLANS.
- M. PROVIDE ROUGH IN AND WIRING FOR ACCESS CONTROL. REFER TO 'T' SERIES SHEETS FOR ADDITIONAL INFORMATION.
- N. LOW VOLTAGE/COMMUNICATIONS SYSTEM DEMARCATION BOARD(S). COORDINATE LOCATIONS AND ELECTRICAL POWER REQUIREMENTS WITH THE TELECOM PLANS ('T' SERIES SHEETS) AND LOW VOLTAGE SYSTEMS INSTALLERS. PROVIDE ROUGH IN AND/OR FINAL ELECTRICAL POWER CONNECTIONS & DEVICES. REFER PANEL 'HP2' SCHEDULE ON E1.12 FOR CIRCUITS.
- O. REFER TO SHEET E1.12 FOR TYPICAL DWELLING UNIT LOAD CENTER SCHEDULE FOR CIRCUITING INFORMATION.
- P. EACH UNIT LOAD CENTER TO BE FED VIA SUB-METERING SYSTEM. REFER TO ONE-LINE DIAGRAM ON SHEET E1.11 FOR CONDUCTOR SIZE AND CABLING.

### 

- 1. PROVIDE KEY BOX FOR PGE AT METER ROOM FOR 24/7 ACCESS.
- GENERATOR EMERGENCY DISCONNECT.
- 3. LAUNDRY ROOM GFCI RECEPTACLES FOR WASHING MACHINES TO BE MOUNTED AT 42" A.F.F., OR UNLESS OTHERWISE DIRECTED BY THE ARCHITECT. LAUNDRY ROOM APPLIANCES CIRCUITED TO PANEL 'HP3'. REFER TO PANEL SCHEDULE ON SHEET E1.12.
- 4. 40A, DEDICATED 14-40R DRYER RECEPTACLE (TYPICAL). VERIFY EXACT POWER RATING REQUIRED FOR THE COMMERCIAL DRYERS PRIOR TO ORDERING. LAUNDRY ROOM APPLIANCES CIRCUITED TO PANEL 'HP3'. REFER TO PANEL SCHEDULE ON SHEET E1.12.
- EXHAUST FAN IN THIS AREA TO BE TIED INTO THE LIGHTING CIRCUIT.
- CONSULT ELEVATOR PROVIDER FOR EXACT POWER REQUIREMENTS AND PROVIDE ALL ELECTRICAL WORK AS DIRECTED. VERIFY EXACT LOCATION FOR ELEVATOR EQUIPMENT WITH ARCHITECT AND COORDINATE WITH ELEVATOR INSTALLER.
- SMOKE DAMPER FOR VENTILATION LOUVER. COORDINATE WITH MECHANICAL EQUIPMENT INSTALLER AND CIRCUIT AS INDICATED
- 8. PROVIDE POWER CONNECTION FOR IRRIGATION CONTROLS. COORDINATE WITH THE LANDSCAPER FOR EXACT REQUIREMENTS AND LOCATION PRIOR TO ROUGH IN.
- 9. CONSULT FIRE SPRINKLER SYSTEM PLAN SET AND COORDINATE EXACT LOCATION AND ELECTRICAL REQUIREMENTS FOR THE BUILDING FIRE PUMP.
- REFER TO THE HOUSE PANEL 'HP1' PANEL SCHEDULE FOR CORRIDOR RECEPTACLE CIRCUITS ON FLOOR 2 THROUGH 11.
- 11. REFER TO PLUMBING PLAN SHEETS FOR ADDITIONAL INFORMATION ON THE PUMP SYSTEMS IN THIS SPACE. COORDINATE WITH INSTALLER AND PROVIDE ELECTRICAL CONNECTIONS AS REQUIRED. PROVIDE CIRCUITS FROM PANEL HP2, SEE PANEL SCHEDULES.
- 12. PROVIDE ONE 20A, 120V, 1P CIRCUIT FROM PANEL HP3 FOR DRYER BOOSTER FANS. COORDINATE WITH MECHANICAL EQUIPMENT
- INSTALLER FOR WIRING REQUIREMENTS PRIOR TO ROUGH IN.

  13. PROVIDE ONE 20A, 120V, 1P CIRCUIT FROM PANEL EP2 FOR AUTOMATIC DOOR CLOSER(S), TIED TO FIRE ALARM SYSTEM.


  COORDINATE WITH FIRE ALARM EQUIPMENT INSTALLER FOR WIRING REQUIREMENTS PRIOR TO ROUGH IN.
- STAIRWELL PRESSURIZATION FANS ARE INTERLOCKED WITH MOTORIZED SMOKE DAMPERS AND BAROMETRIC RELIEF DAMPERS. REFER TO MECHANICAL PLANS SHEETS AND COORDINATE WITH THE MECHANICAL EQUIPMENT INSTALLER FOR ADDITIONAL INFORMATION.

  BOTH THE PRESSURIZATION FANS AND DAMPERS ARE TO BE CIRCUITED TO THE EMERGENCY POWER SYSTEM AND VIA THE FACP. SEE PANEL EP2 FOR PROPOSED CIRCUITING.

*POWER SHALL BE MONITORED DOWN STREAM OF THE DISCONNECTS.

*PROVIDE CURRENT TRANSDUCER TO MONITOR FAN AIRFLOW (HAWKEYE 608 OR EQUAL).



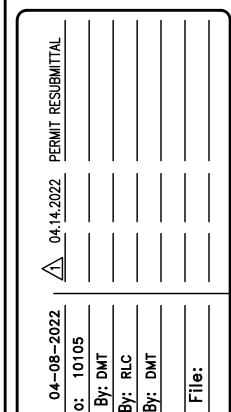

OREGON

RYSTADT 57 SW PARK AVE.

**TLAND** 


 $\searrow$ 



Consulting Engineers 2007 S.E. Ash St. Portland, OR 97214 PHN: (503) 234-0548 FAX: (503) 234-0677 WWW.MFIA-ENG.COM

SHEET

E3.03

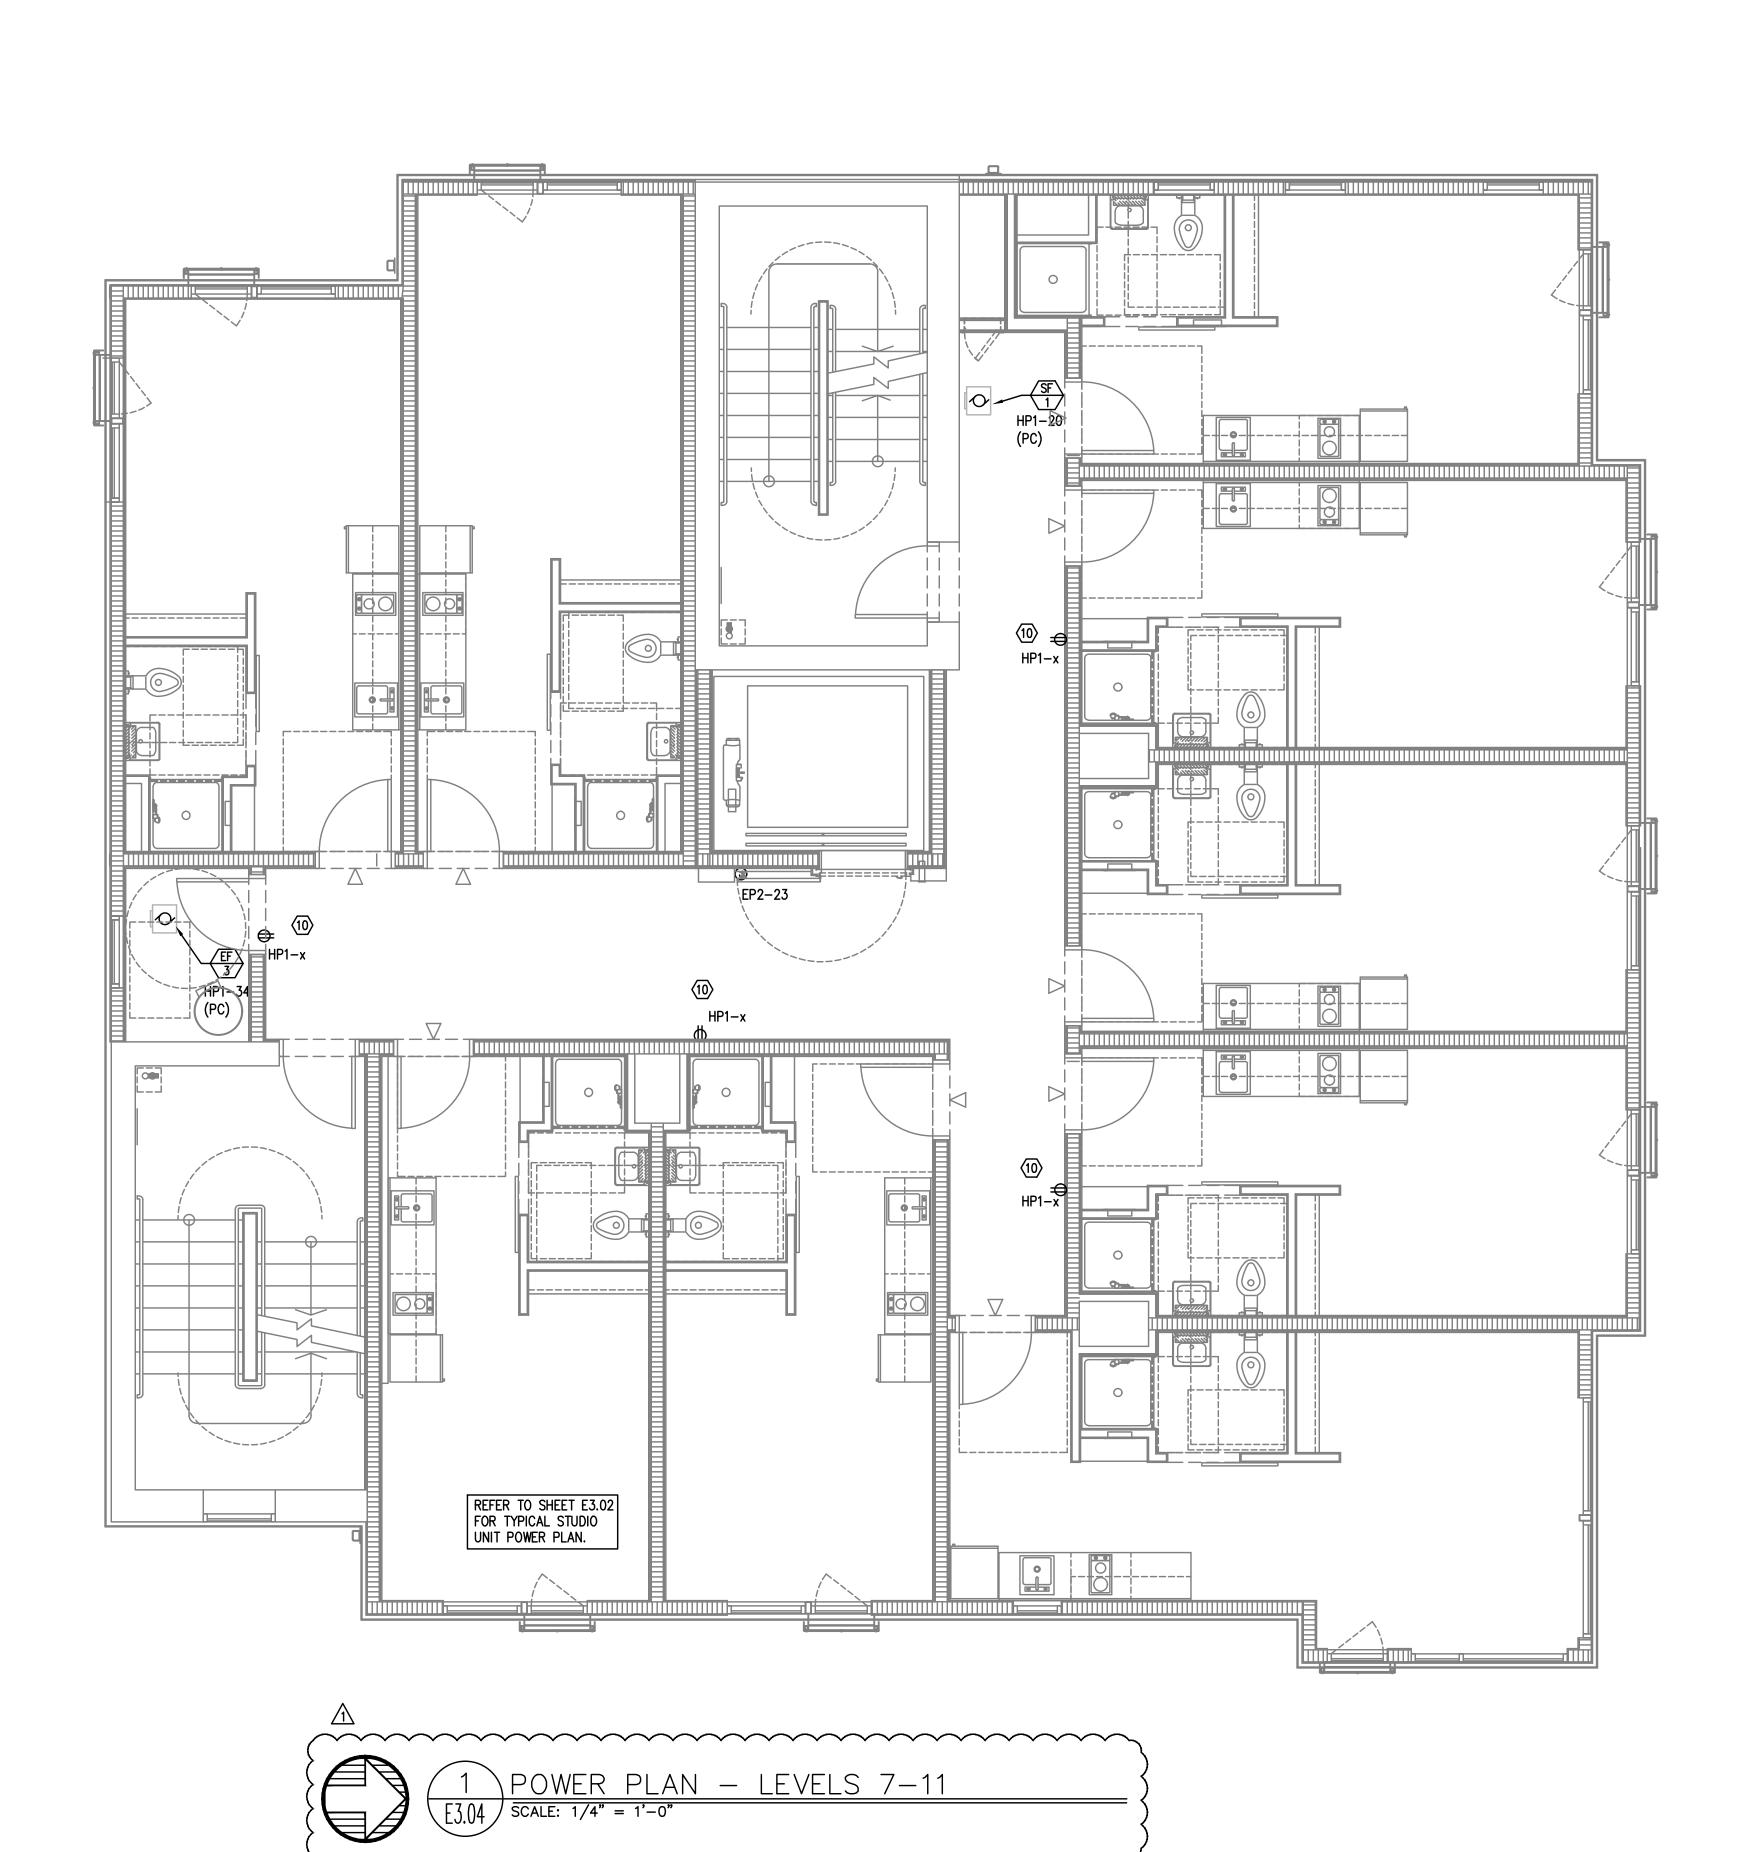

#### GENERAL POWER NOTES:

- A. ELECTRICAL DRAWINGS ARE DIAGRAMMATICAL AND MAY NOT ACCURATELY REFLECT ACTUAL CONSTRUCTION CONDITIONS. THE ELECTRICAL CONTRACTOR SHALL BE RESPONSIBLE FOR COORDINATING THE INSTALLATION OF ALL ELECTRICAL EQUIPMENT, WITH ALL TRADES PRIOR TO AND DURING CONSTRUCTION.
- B. WORK SHALL BE IN ACCORDANCE WITH ALL APPLICABLE LOCAL, STATE AND NATIONAL CODES.
- ELECTRICAL CONTRACTOR TO PROVIDE THERMOSTATS NOT SUPPLIED BY MECHANICAL CONTRACTOR, AS REQUIRED. CONSULT MECHANICAL PLANS FOR ADDITIONAL INFORMATION.
- D. ELECTRICAL CONTRACTOR SHALL PROVIDE INSTALLATION AND FINAL CONNECTION OF THERMOSTATS AS REQUIRED. CONSULT MECHANICAL CONTRACTOR FOR EXACT REQUIREMENTS PRIOR TO ROUGH IN.
- E. COORDINATE WITH DIVISION 23 FOR EXACT LOCATION AND POWER REQUIREMENTS OF ALL MECHANICAL EQUIPMENT PRIOR TO ROUGH IN. REFER TO SHEET E1.13 FOR MECHANICAL EQUIPMENT SCHEDULE.
- F. THE ELECTRICAL CONTRACTOR SHALL REFER TO THE ARCHITECTURAL DRAWINGS FOR ALL MOUNTING HEIGHTS AND FINISHES OF DEVICES AND FIXTURES.
- G. ELECTRICAL CONTRACTOR SHALL REFER TO THE 'T' SERIES SHEETS AND PROVIDE ROUGH IN FOR THE LOW VOLTAGE SYSTEMS/FIRE
- H. SERVICE ENTRANCE AND METERING EQUIPMENT SHOWN TO APPROXIMATE SCALE, BASED ON SIEMENS PRODUCTS. CONTRACTOR SHALL BE RESPONSIBLE FOR ENSURING THAT INSTALLED EQUIPMENT FITS THE SPACE PROVIDED AND THAT ALL REQUIRED WORKING CLEARANCES ARE PROVIDED.
- I. THE CLASS 'A' TRANSFORMER VAULT SHALL BE IN ACCORDANCE WITH NEC REQUIREMENTS AS WELL AS THOSE OF THE UTILITY PROVIDER. MAN-DOOR SHALL BE EQUIPPED WITH PANIC HARDWARE AND AN OUTWARD SWING.
- J. PROVIDE A KEY BOX AT THE TRANSFORMER ROOM DOOR PER THE UTILITY PROVIDER'S REQUIREMENTS, FOR 24/7 ACCESS.
- TENANT ELECTRICAL METERING SHALL BE SUB-METERED BY THE OWNER PER THE UTILITY PROVIDER'S REQUIREMENTS. SUB-METERING EQUIPMENT IS BASED ON SIEMENS SEM3 PRODUCTS. REFER TO SHEET E1.11 FOR ADDITIONAL INFORMATION.
- L. REFER TO 'E4' SERIES SHEETS FOR TYPICAL DWELLING UNIT POWER PLANS.
- M. PROVIDE ROUGH IN AND WIRING FOR ACCESS CONTROL. REFER TO 'T' SERIES SHEETS FOR ADDITIONAL INFORMATION.
- N. LOW VOLTAGE/COMMUNICATIONS SYSTEM DEMARCATION BOARD(S). COORDINATE LOCATIONS AND ELECTRICAL POWER REQUIREMENTS WITH THE TELECOM PLANS ('T' SERIES SHEETS) AND LOW VOLTAGE SYSTEMS INSTALLERS. PROVIDE ROUGH IN AND/OR FINAL ELECTRICAL POWER CONNECTIONS & DEVICES. REFER PANEL 'HP2' SCHEDULE ON E1.12 FOR CIRCUITS.
- O. REFER TO SHEET E1.12 FOR TYPICAL DWELLING UNIT LOAD CENTER SCHEDULE FOR CIRCUITING INFORMATION.
- P. EACH UNIT LOAD CENTER TO BE FED VIA SUB-METERING SYSTEM. REFER TO ONE-LINE DIAGRAM ON SHEET E1.11 FOR CONDUCTOR SIZE AND CABLING.

### 

- 1. PROVIDE KEY BOX FOR PGE AT METER ROOM FOR 24/7 ACCESS.
- GENERATOR EMERGENCY DISCONNECT.
- 3. LAUNDRY ROOM GFCI RECEPTACLES FOR WASHING MACHINES TO BE MOUNTED AT 42" A.F.F., OR UNLESS OTHERWISE DIRECTED BY THE ARCHITECT. LAUNDRY ROOM APPLIANCES CIRCUITED TO PANEL 'HP3'. REFER TO PANEL SCHEDULE ON SHEET E1.12.
- 4. 40A, DEDICATED 14—40R DRYER RECEPTACLE (TYPICAL). VERIFY EXACT POWER RATING REQUIRED FOR THE COMMERCIAL DRYERS PRIOR TO ORDERING. LAUNDRY ROOM APPLIANCES CIRCUITED TO PANEL 'HP3'. REFER TO PANEL SCHEDULE ON SHEET E1.12.
- EXHAUST FAN IN THIS AREA TO BE TIED INTO THE LIGHTING CIRCUIT.
- 6. CONSULT ELEVATOR PROVIDER FOR EXACT POWER REQUIREMENTS AND PROVIDE ALL ELECTRICAL WORK AS DIRECTED. VERIFY EXACT LOCATION FOR ELEVATOR EQUIPMENT WITH ARCHITECT AND COORDINATE WITH ELEVATOR INSTALLER.
- 7. SMOKE DAMPER FOR VENTILATION LOUVER. COORDINATE WITH MECHANICAL EQUIPMENT INSTALLER AND CIRCUIT AS INDICATED
- 8. PROVIDE POWER CONNECTION FOR IRRIGATION CONTROLS. COORDINATE WITH THE LANDSCAPER FOR EXACT REQUIREMENTS AND LOCATION PRIOR TO ROUGH IN.
- ONSULT FIRE SPRINKLER SYSTEM PLAN SET AND COORDINATE EXACT LOCATION AND ELECTRICAL REQUIREMENTS FOR THE
- O. REFER TO THE HOUSE PANEL 'HP1' PANEL SCHEDULE FOR CORRIDOR RECEPTACLE CIRCUITS ON FLOOR 2 THROUGH 11.
- 11. REFER TO PLUMBING PLAN SHEETS FOR ADDITIONAL INFORMATION ON THE PUMP SYSTEMS IN THIS SPACE. COORDINATE WITH INSTALLER AND PROVIDE ELECTRICAL CONNECTIONS AS REQUIRED. PROVIDE CIRCUITS FROM PANEL HP2, SEE PANEL SCHEDULES.
- 12. PROVIDE ONE 20A, 120V, 1P CIRCUIT FROM PANEL HP3 FOR DRYER BOOSTER FANS. COORDINATE WITH MECHANICAL EQUIPMENT
  INSTALLER FOR WIRING REQUIREMENTS PRIOR TO ROUGH IN.
- PROVIDE ONE 20A, 120V, 1P CIRCUIT FROM PANEL EP2 FOR AUTOMATIC DOOR CLOSER(S), TIED TO FIRE ALARM SYSTEM.


  COORDINATE WITH FIRE ALARM EQUIPMENT INSTALLER FOR WIRING REQUIREMENTS PRIOR TO ROUGH IN.
- 14. STAIRWELL PRESSURIZATION FANS ARE INTERLOCKED WITH MOTORIZED SMOKE DAMPERS AND BAROMETRIC RELIEF DAMPERS. REFER TO MECHANICAL PLANS SHEETS AND COORDINATE WITH THE MECHANICAL EQUIPMENT INSTALLER FOR ADDITIONAL INFORMATION.

  BOTH THE PRESSURIZATION FANS AND DAMPERS ARE TO BE CIRCUITED TO THE EMERGENCY POWER SYSTEM AND VIA THE FACP. SEE PANEL EP2 FOR PROPOSED CIRCUITING.

*POWER SHALL BE MONITORED DOWN STREAM OF THE DISCONNECTS.

*PROVIDE CURRENT TRANSDUCER TO MONITOR FAN AIRFLOW (HAWKEYE 608 OR EQUAL).



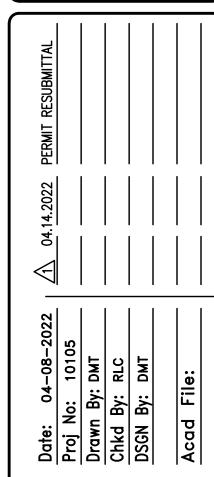

OREGON

0

RYSTADI 57 SW PARK AVE.

AND


 $\gtrsim$ 



Consulting Engineers 2007 S.E. Ash St. Portland, OR 97214 PHN: (503) 234-0548 FAX: (503) 234-0677 WWW.MFIA-ENG.COM

SHEET

E3.04

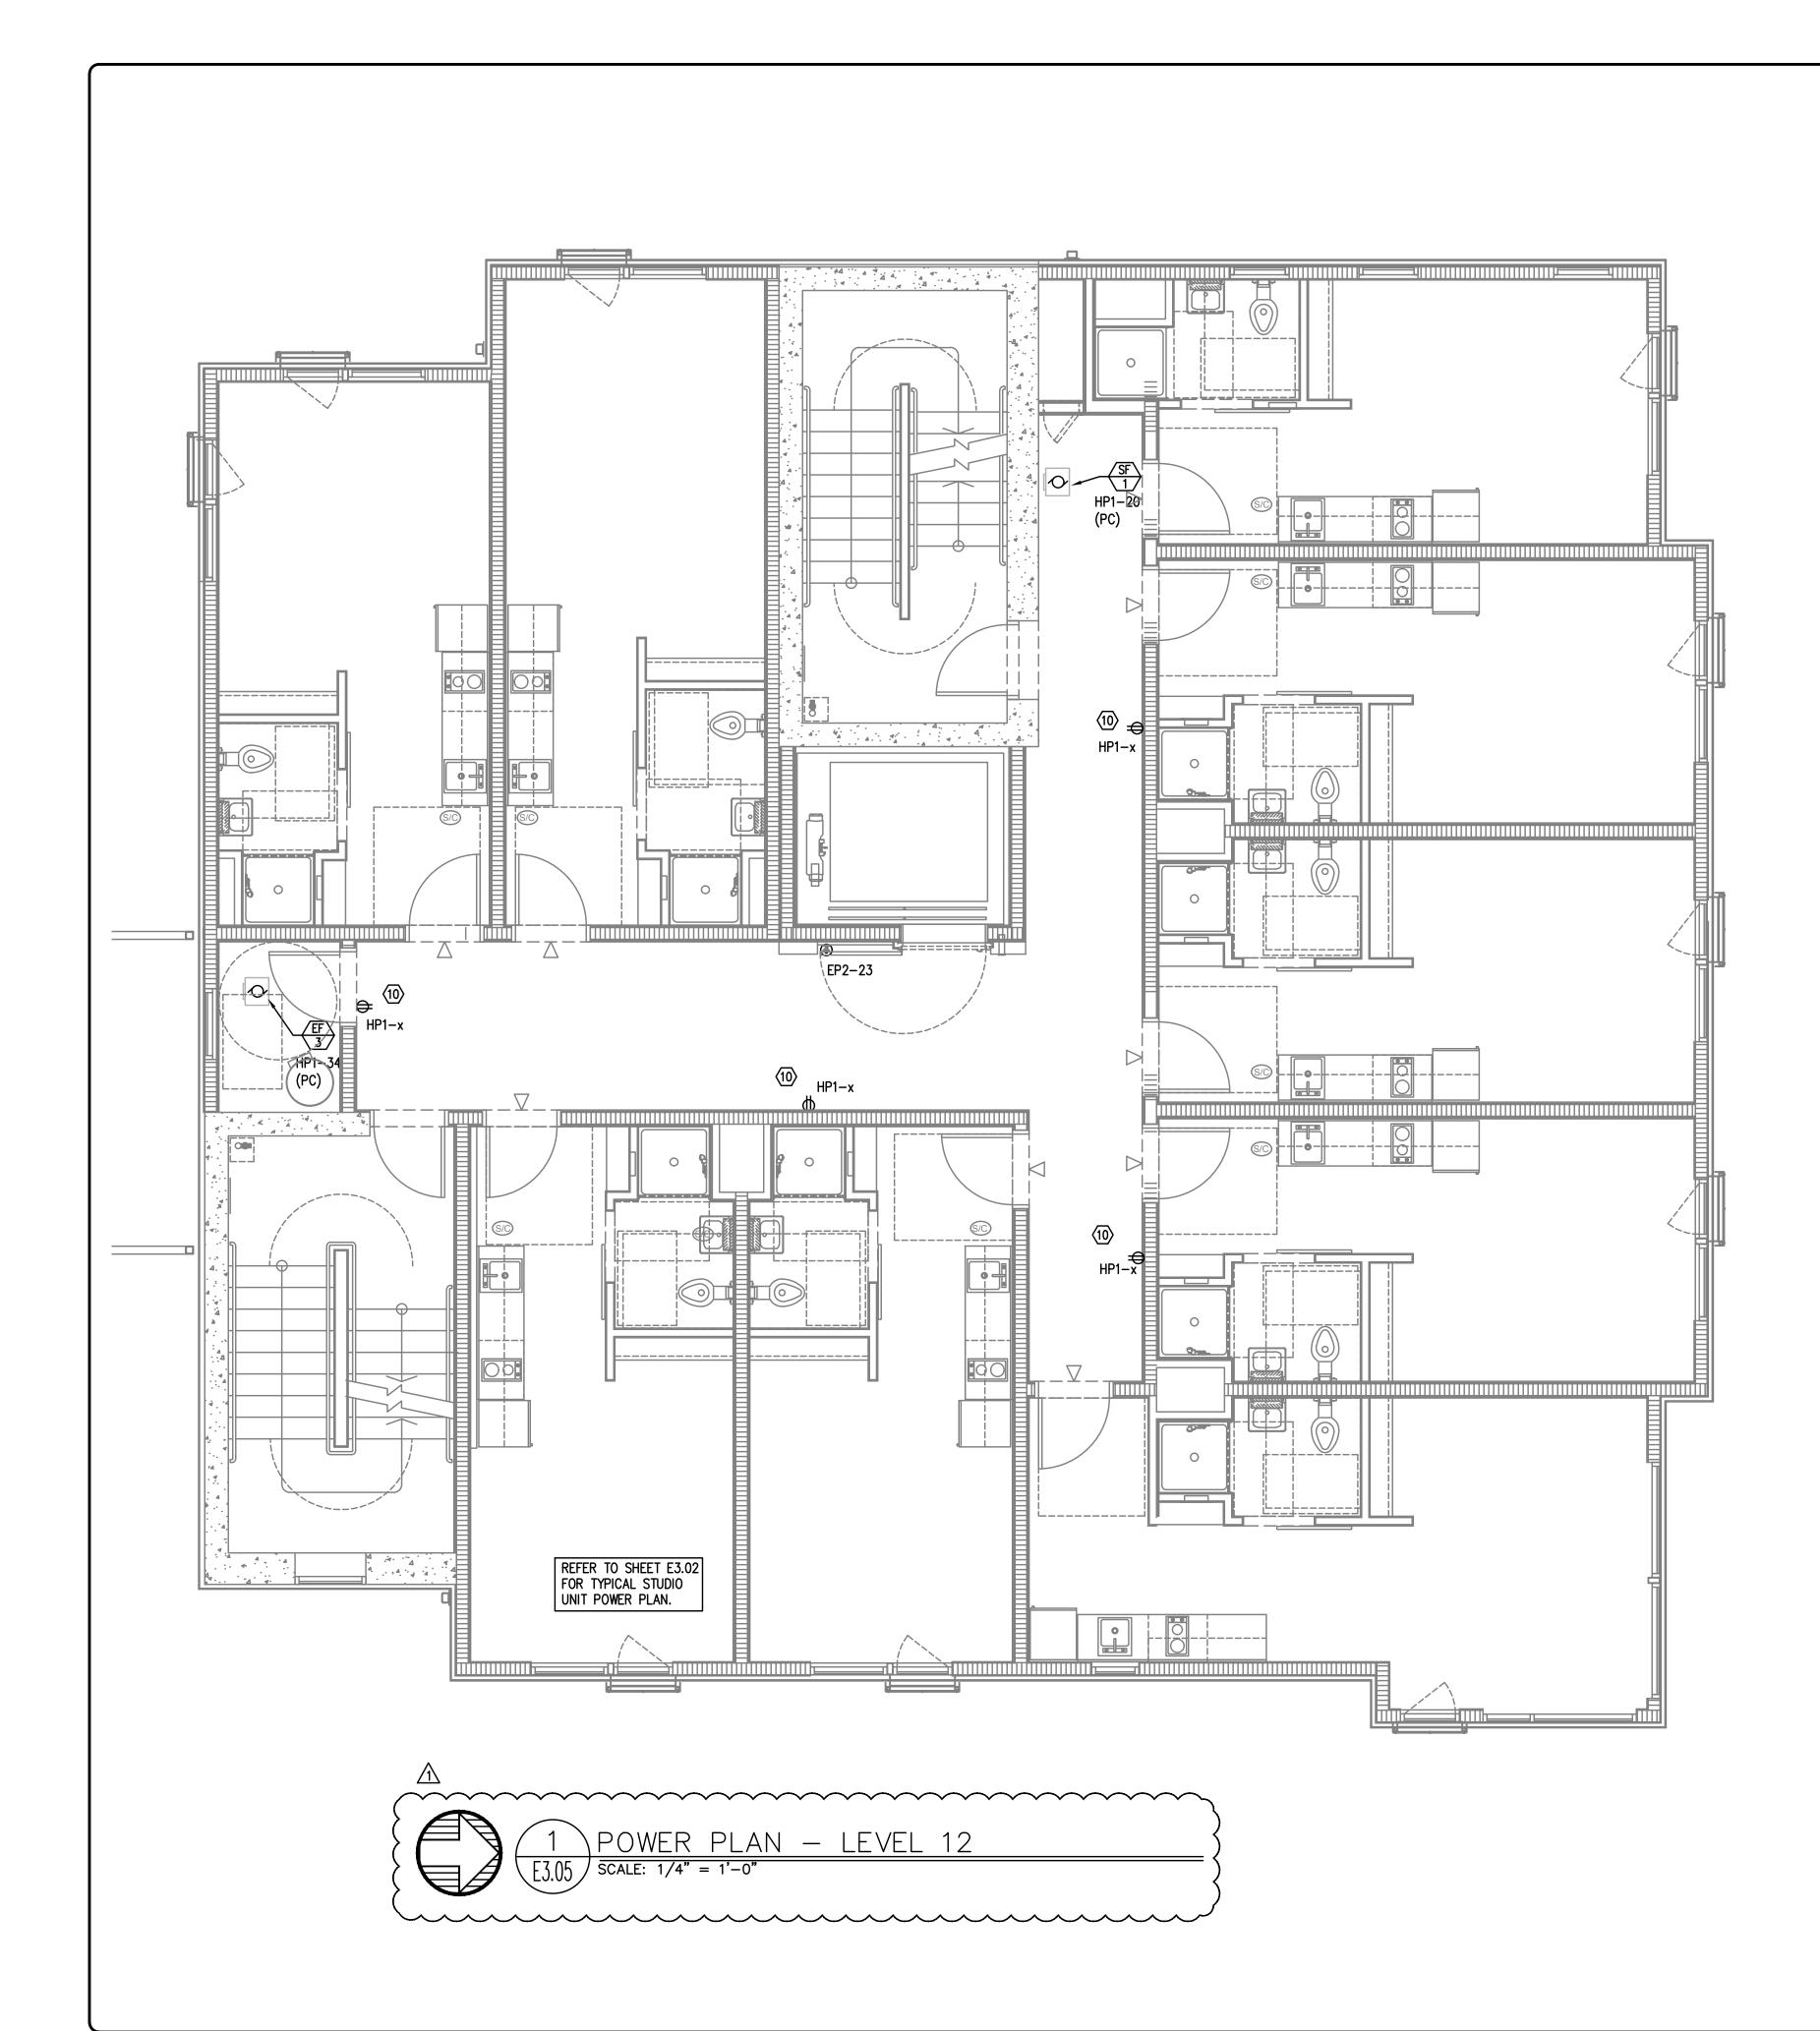

- A. ELECTRICAL DRAWINGS ARE DIAGRAMMATICAL AND MAY NOT ACCURATELY REFLECT ACTUAL CONSTRUCTION CONDITIONS. THE ELECTRICAL CONTRACTOR SHALL BE RESPONSIBLE FOR COORDINATING THE INSTALLATION OF ALL ELECTRICAL EQUIPMENT, WITH ALL TRADES PRIOR TO AND DURING CONSTRUCTION.
- B. WORK SHALL BE IN ACCORDANCE WITH ALL APPLICABLE LOCAL, STATE AND NATIONAL CODES.
- ELECTRICAL CONTRACTOR TO PROVIDE THERMOSTATS NOT SUPPLIED BY MECHANICAL CONTRACTOR, AS REQUIRED. CONSULT MECHANICAL PLANS FOR ADDITIONAL INFORMATION.
- D. ELECTRICAL CONTRACTOR SHALL PROVIDE INSTALLATION AND FINAL CONNECTION OF THERMOSTATS AS REQUIRED. CONSULT MECHANICAL CONTRACTOR FOR EXACT REQUIREMENTS PRIOR TO ROUGH IN.
- E. COORDINATE WITH DIVISION 23 FOR EXACT LOCATION AND POWER REQUIREMENTS OF ALL MECHANICAL EQUIPMENT PRIOR TO ROUGH IN. REFER TO SHEET E1.13 FOR MECHANICAL EQUIPMENT SCHEDULE.
- F. THE ELECTRICAL CONTRACTOR SHALL REFER TO THE ARCHITECTURAL DRAWINGS FOR ALL MOUNTING HEIGHTS AND FINISHES OF DEVICES AND FIXTURES.
- G. ELECTRICAL CONTRACTOR SHALL REFER TO THE 'T' SERIES SHEETS AND PROVIDE ROUGH IN FOR THE LOW VOLTAGE SYSTEMS/FIRE
- H. SERVICE ENTRANCE AND METERING EQUIPMENT SHOWN TO APPROXIMATE SCALE, BASED ON SIEMENS PRODUCTS. CONTRACTOR SHALL BE RESPONSIBLE FOR ENSURING THAT INSTALLED EQUIPMENT FITS THE SPACE PROVIDED AND THAT ALL REQUIRED WORKING CLEARANCES ARE PROVIDED.
- 1. THE CLASS 'A' TRANSFORMER VAULT SHALL BE IN ACCORDANCE WITH NEC REQUIREMENTS AS WELL AS THOSE OF THE UTILITY PROVIDER. MAN—DOOR SHALL BE EQUIPPED WITH PANIC HARDWARE AND AN OUTWARD SWING.
- J. PROVIDE A KEY BOX AT THE TRANSFORMER ROOM DOOR PER THE UTILITY PROVIDER'S REQUIREMENTS, FOR 24/7 ACCESS.
- TENANT ELECTRICAL METERING SHALL BE SUB-METERED BY THE OWNER PER THE UTILITY PROVIDER'S REQUIREMENTS. SUB-METERING EQUIPMENT IS BASED ON SIEMENS SEM3 PRODUCTS. REFER TO SHEET E1.11 FOR ADDITIONAL INFORMATION.
- L. REFER TO 'E4' SERIES SHEETS FOR TYPICAL DWELLING UNIT POWER PLANS.
- M. PROVIDE ROUGH IN AND WIRING FOR ACCESS CONTROL. REFER TO 'T' SERIES SHEETS FOR ADDITIONAL INFORMATION.
- N. LOW VOLTAGE/COMMUNICATIONS SYSTEM DEMARCATION BOARD(S). COORDINATE LOCATIONS AND ELECTRICAL POWER REQUIREMENTS WITH THE TELECOM PLANS ('T' SERIES SHEETS) AND LOW VOLTAGE SYSTEMS INSTALLERS. PROVIDE ROUGH IN AND/OR FINAL ELECTRICAL POWER CONNECTIONS & DEVICES. REFER PANEL 'HP2' SCHEDULE ON E1.12 FOR CIRCUITS.
- O. REFER TO SHEET E1.12 FOR TYPICAL DWELLING UNIT LOAD CENTER SCHEDULE FOR CIRCUITING INFORMATION.
- P. EACH UNIT LOAD CENTER TO BE FED VIA SUB-METERING SYSTEM. REFER TO ONE-LINE DIAGRAM ON SHEET E1.11 FOR CONDUCTOR SIZE AND CABLING.

### 

- 1. PROVIDE KEY BOX FOR PGE AT METER ROOM FOR 24/7 ACCESS.
- . GENERATOR EMERGENCY DISCONNECT.
- 3. LAUNDRY ROOM GFCI RECEPTACLES FOR WASHING MACHINES TO BE MOUNTED AT 42" A.F.F., OR UNLESS OTHERWISE DIRECTED BY THE ARCHITECT. LAUNDRY ROOM APPLIANCES CIRCUITED TO PANEL 'HP3'. REFER TO PANEL SCHEDULE ON SHEET E1.12.
- 4. 40A, DEDICATED 14—40R DRYER RECEPTACLE (TYPICAL). VERIFY EXACT POWER RATING REQUIRED FOR THE COMMERCIAL DRYERS PRIOR TO ORDERING. LAUNDRY ROOM APPLIANCES CIRCUITED TO PANEL 'HP3'. REFER TO PANEL SCHEDULE ON SHEET E1.12.
- EXHAUST FAN IN THIS AREA TO BE TIED INTO THE LIGHTING CIRCUIT.
- 6. CONSULT ELEVATOR PROVIDER FOR EXACT POWER REQUIREMENTS AND PROVIDE ALL ELECTRICAL WORK AS DIRECTED. VERIFY EXACT LOCATION FOR ELEVATOR EQUIPMENT WITH ARCHITECT AND COORDINATE WITH ELEVATOR INSTALLER.
- 7. SMOKE DAMPER FOR VENTILATION LOUVER. COORDINATE WITH MECHANICAL EQUIPMENT INSTALLER AND CIRCUIT AS INDICATED
- 8. PROVIDE POWER CONNECTION FOR IRRIGATION CONTROLS. COORDINATE WITH THE LANDSCAPER FOR EXACT REQUIREMENTS AND LOCATION PRIOR TO ROUGH IN.
- ONSULT FIRE SPRINKLER SYSTEM PLAN SET AND COORDINATE EXACT LOCATION AND ELECTRICAL REQUIREMENTS FOR THE BUILDING FIRE PUMP.
- REFER TO THE HOUSE PANEL 'HP1' PANEL SCHEDULE FOR CORRIDOR RECEPTACLE CIRCUITS ON FLOOR 2 THROUGH 11.
- 11. REFER TO PLUMBING PLAN SHEETS FOR ADDITIONAL INFORMATION ON THE PUMP SYSTEMS IN THIS SPACE. COORDINATE WITH INSTALLER AND PROVIDE ELECTRICAL CONNECTIONS AS REQUIRED. PROVIDE CIRCUITS FROM PANEL HP2, SEE PANEL SCHEDULES.
- 12. PROVIDE ONE 20A, 120V, 1P CIRCUIT FROM PANEL HP3 FOR DRYER BOOSTER FANS. COORDINATE WITH MECHANICAL EQUIPMENT
- INSTALLER FOR WIRING REQUIREMENTS PRIOR TO ROUGH IN.

  13. PROVIDE ONE 20A, 120V, 1P CIRCUIT FROM PANEL EP2 FOR AUTOMATIC DOOR CLOSER(S), TIED TO FIRE ALARM SYSTEM.

  COORDINATE WITH FIRE ALARM EQUIPMENT INSTALLER FOR WIRING REQUIREMENTS PRIOR TO ROUGH IN.
- STAIRWELL PRESSURIZATION FANS ARE INTERLOCKED WITH MOTORIZED SMOKE DAMPERS AND BAROMETRIC RELIEF DAMPERS. REFER TO MECHANICAL PLANS SHEETS AND COORDINATE WITH THE MECHANICAL EQUIPMENT INSTALLER FOR ADDITIONAL INFORMATION.

  BOTH THE PRESSURIZATION FANS AND DAMPERS ARE TO BE CIRCUITED TO THE EMERGENCY POWER SYSTEM AND VIA THE FACP. SEE PANEL EP2 FOR PROPOSED CIRCUITING.


______

*POWER SHALL BE MONITORED DOWN STREAM OF THE DISCONNECTS.

*PROVIDE CURRENT TRANSDUCER TO MONITOR FAN AIRFLOW (HAWKEYE 608 OR EQUAL).

OLACO A TOAKIOCODIACO VIALUET OCKICOAL KIOTCO



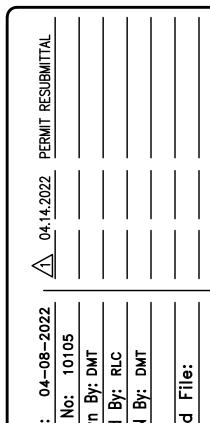

NOS

2057 SW PARK AVE.


TLAND



Consulting Engineers 2007 S.E. Ash St. Portland, OR 97214 PHN: (503) 234-0548 FAX: (503) 234-0677 WWW.MFIA-ENG.COM

SHEET

E3.05

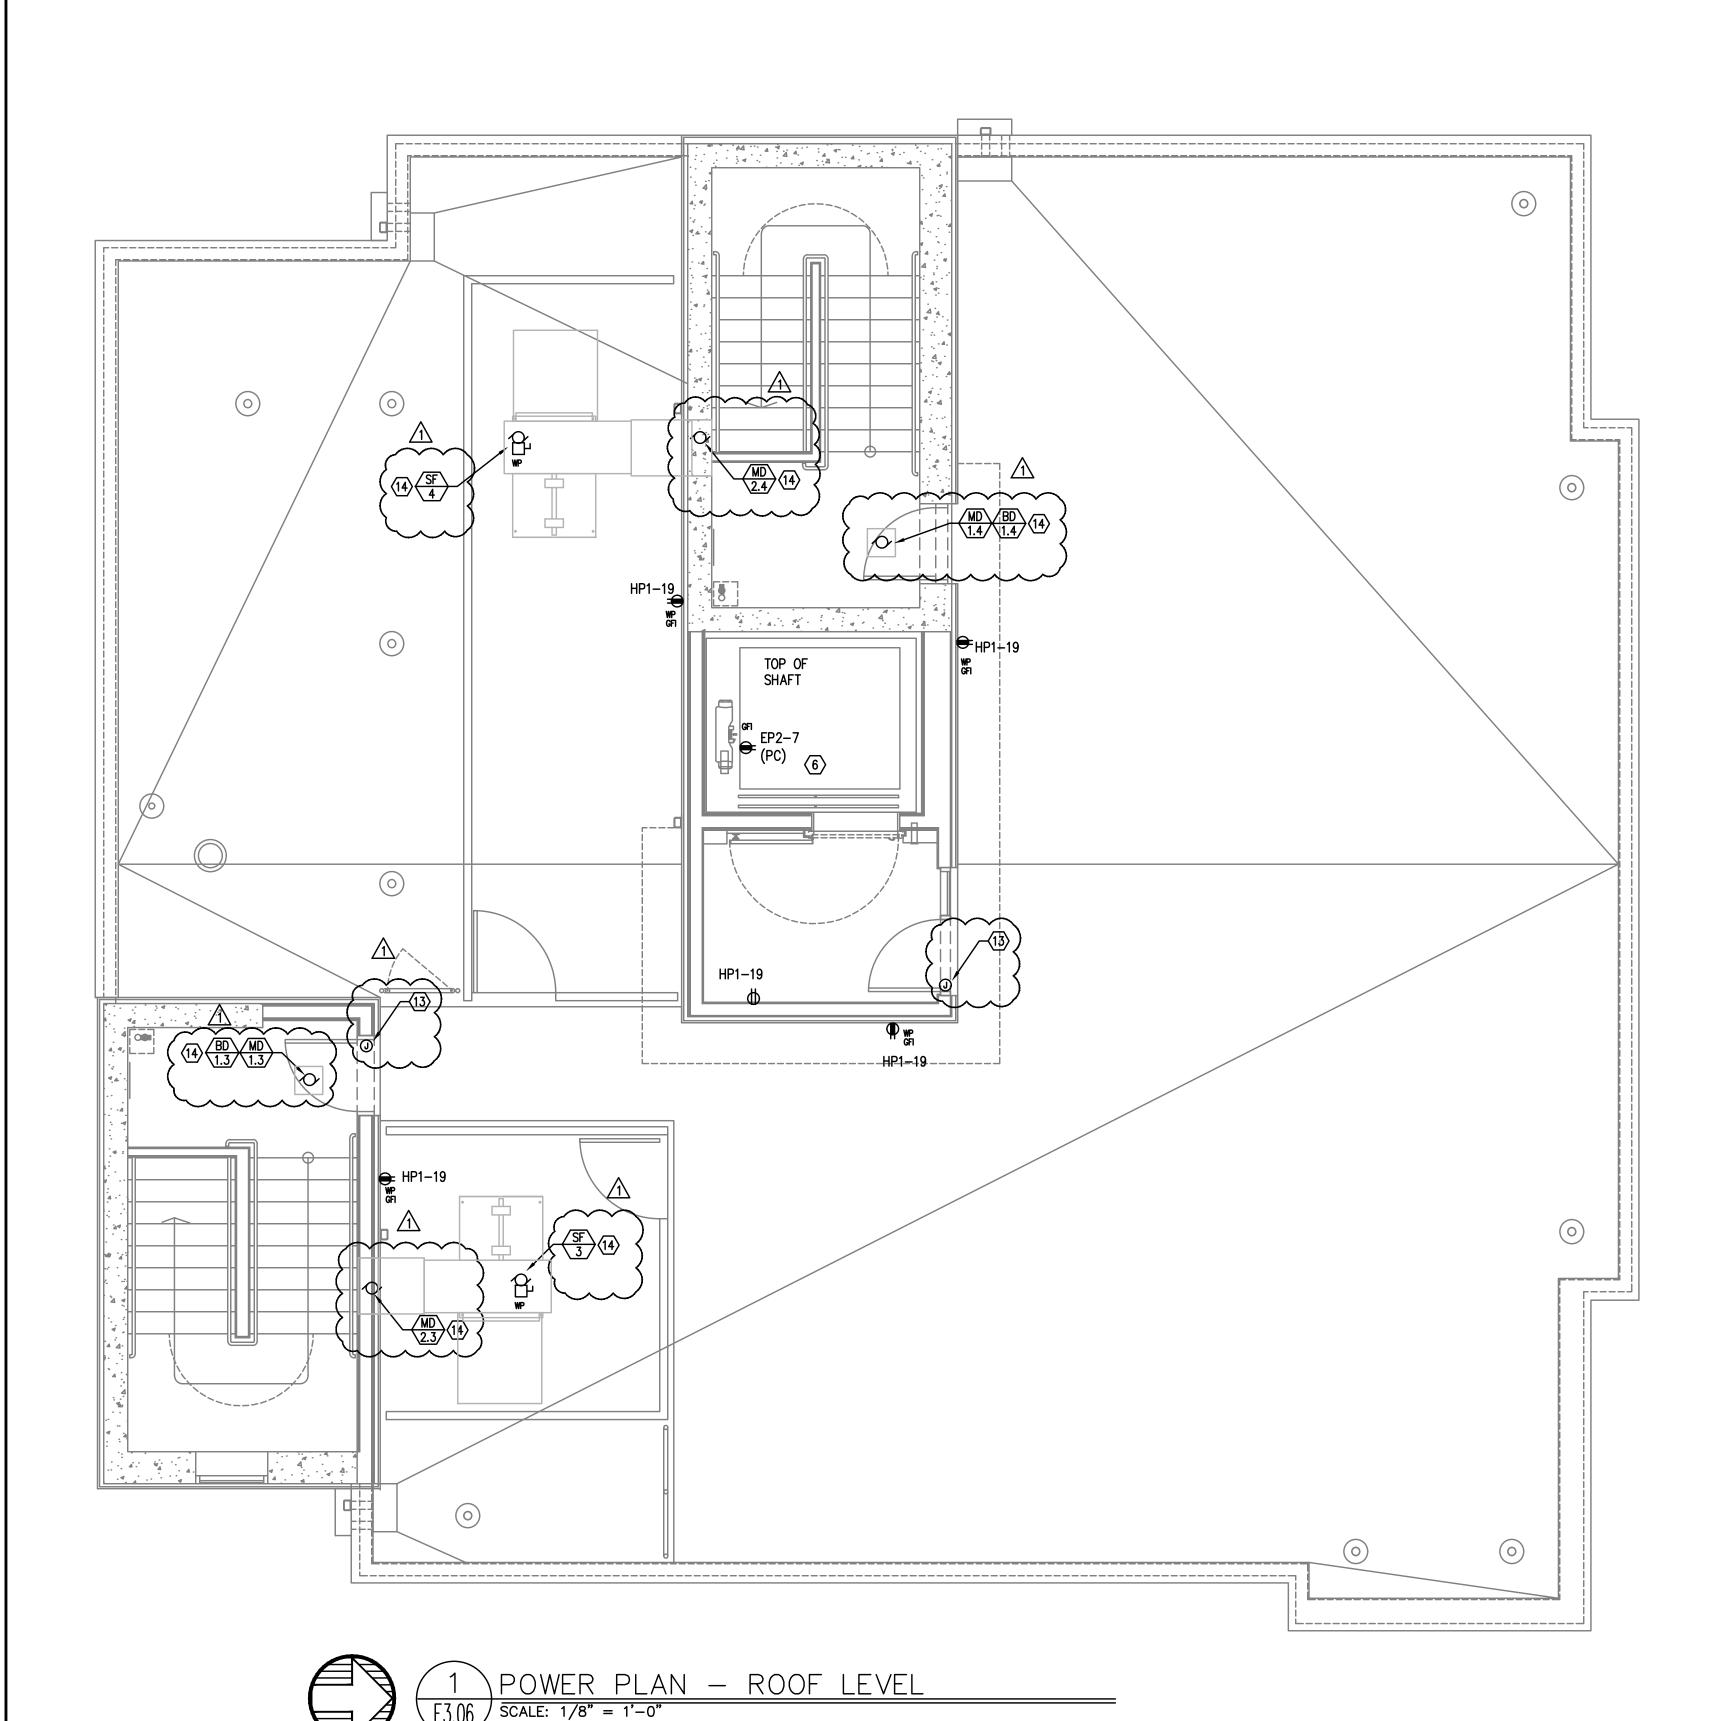

- A. ELECTRICAL DRAWINGS ARE DIAGRAMMATICAL AND MAY NOT ACCURATELY REFLECT ACTUAL CONSTRUCTION CONDITIONS. THE ELECTRICAL CONTRACTOR SHALL BE RESPONSIBLE FOR COORDINATING THE INSTALLATION OF ALL ELECTRICAL EQUIPMENT, WITH ALL TRADES PRIOR TO AND DURING CONSTRUCTION.
- B. WORK SHALL BE IN ACCORDANCE WITH ALL APPLICABLE LOCAL, STATE AND NATIONAL CODES.
- C. ELECTRICAL CONTRACTOR TO PROVIDE THERMOSTATS NOT SUPPLIED BY MECHANICAL CONTRACTOR, AS REQUIRED. CONSULT MECHANICAL PLANS FOR ADDITIONAL INFORMATION.
- D. ELECTRICAL CONTRACTOR SHALL PROVIDE INSTALLATION AND FINAL CONNECTION OF THERMOSTATS AS REQUIRED. CONSULT MECHANICAL CONTRACTOR FOR EXACT REQUIREMENTS PRIOR TO ROUGH IN.
- COORDINATE WITH DIVISION 23 FOR EXACT LOCATION AND POWER REQUIREMENTS OF ALL MECHANICAL EQUIPMENT PRIOR TO ROUGH IN. REFER TO SHEET E1.13 FOR MECHANICAL EQUIPMENT SCHEDULE.
- F. THE ELECTRICAL CONTRACTOR SHALL REFER TO THE ARCHITECTURAL DRAWINGS FOR ALL MOUNTING HEIGHTS AND FINISHES OF DEVICES AND FIXTURES.
- G. ELECTRICAL CONTRACTOR SHALL REFER TO THE 'T' SERIES SHEETS AND PROVIDE ROUGH IN FOR THE LOW VOLTAGE SYSTEMS/FIRE ALARM INSTALLER.
- H. SERVICE ENTRANCE AND METERING EQUIPMENT SHOWN TO APPROXIMATE SCALE, BASED ON SIEMENS PRODUCTS. CONTRACTOR SHALL BE RESPONSIBLE FOR ENSURING THAT INSTALLED EQUIPMENT FITS THE SPACE PROVIDED AND THAT ALL REQUIRED WORKING CLEARANCES ARE PROVIDED.
- THE CLASS 'A' TRANSFORMER VAULT SHALL BE IN ACCORDANCE WITH NEC REQUIREMENTS AS WELL AS THOSE OF THE UTILITY PROVIDER. MAN-DOOR SHALL BE EQUIPPED WITH PANIC HARDWARE AND AN OUTWARD SWING.
- J. PROVIDE A KEY BOX AT THE TRANSFORMER ROOM DOOR PER THE UTILITY PROVIDER'S REQUIREMENTS, FOR 24/7 ACCESS.
- K. TENANT ELECTRICAL METERING SHALL BE SUB-METERED BY THE OWNER PER THE UTILITY PROVIDER'S REQUIREMENTS. SUB-METERING EQUIPMENT IS BASED ON SIEMENS SEM3 PRODUCTS. REFER TO SHEET E1.11 FOR ADDITIONAL INFORMATION.
- L. REFER TO 'E4' SERIES SHEETS FOR TYPICAL DWELLING UNIT POWER PLANS.
- M. PROVIDE ROUGH IN AND WIRING FOR ACCESS CONTROL. REFER TO 'T' SERIES SHEETS FOR ADDITIONAL INFORMATION.
- N. LOW VOLTAGE/COMMUNICATIONS SYSTEM DEMARCATION BOARD(S). COORDINATE LOCATIONS AND ELECTRICAL POWER REQUIREMENTS WITH THE TELECOM PLANS ('T' SERIES SHEETS) AND LOW VOLTAGE SYSTEMS INSTALLERS. PROVIDE ROUGH IN AND/OR FINAL ELECTRICAL POWER CONNECTIONS & DEVICES. REFER PANEL 'HP2' SCHEDULE ON E1.12 FOR CIRCUITS.
- O. REFER TO SHEET E1.12 FOR TYPICAL DWELLING UNIT LOAD CENTER SCHEDULE FOR CIRCUITING INFORMATION.
- P. EACH UNIT LOAD CENTER TO BE FED VIA SUB-METERING SYSTEM. REFER TO ONE-LINE DIAGRAM ON SHEET E1.11 FOR CONDUCTOR SIZE AND CABLING.

#### 


- 1. PROVIDE KEY BOX FOR PGE AT METER ROOM FOR 24/7 ACCESS.
- GENERATOR EMERGENCY DISCONNECT.
- LAUNDRY ROOM GFCI RECEPTACLES FOR WASHING MACHINES TO BE MOUNTED AT 42" A.F.F., OR UNLESS OTHERWISE DIRECTED BY THE ARCHITECT. LAUNDRY ROOM APPLIANCES CIRCUITED TO PANEL 'HP3'. REFER TO PANEL SCHEDULE ON SHEET E1.12.
- 4. 40A, DEDICATED 14-40R DRYER RECEPTACLE (TYPICAL). VERIFY EXACT POWER RATING REQUIRED FOR THE COMMERCIAL DRYERS PRIOR TO ORDERING. LAUNDRY ROOM APPLIANCES CIRCUITED TO PANEL 'HP3'. REFER TO PANEL SCHEDULE ON SHEET E1.12.
- 5. EXHAUST FAN IN THIS AREA TO BE TIED INTO THE LIGHTING CIRCUIT.
- CONSULT ELEVATOR PROVIDER FOR EXACT POWER REQUIREMENTS AND PROVIDE ALL ELECTRICAL WORK AS DIRECTED. VERIFY EXACT LOCATION FOR ELEVATOR EQUIPMENT WITH ARCHITECT AND COORDINATE WITH ELEVATOR INSTALLER.
- SMOKE DAMPER FOR VENTILATION LOUVER. COORDINATE WITH MECHANICAL EQUIPMENT INSTALLER AND CIRCUIT AS INDICATED
- 8. PROVIDE POWER CONNECTION FOR IRRIGATION CONTROLS. COORDINATE WITH THE LANDSCAPER FOR EXACT REQUIREMENTS AND
- LOCATION PRIOR TO ROUGH IN.
- ONSULT FIRE SPRINKLER SYSTEM PLAN SET AND COORDINATE EXACT LOCATION AND ELECTRICAL REQUIREMENTS FOR THE RUILDING FIRE PUMP
- 10. REFER TO THE HOUSE PANEL 'HP1' PANEL SCHEDULE FOR CORRIDOR RECEPTACLE CIRCUITS ON FLOOR 2 THROUGH 11.
- 11. REFER TO PLUMBING PLAN SHEETS FOR ADDITIONAL INFORMATION ON THE PUMP SYSTEMS IN THIS SPACE. COORDINATE WITH INSTALLER AND PROVIDE ELECTRICAL CONNECTIONS AS REQUIRED. PROVIDE CIRCUITS FROM PANEL HP2, SEE PANEL SCHEDULES.
- 12. PROVIDE ONE 20A, 120V, 1P CIRCUIT FROM PANEL HP3 FOR DRYER BOOSTER FANS. COORDINATE WITH MECHANICAL EQUIPMENT
- 13. PROVIDE ONE 20A, 120V, 1P CIRCUIT FROM PANEL EP2 FOR AUTOMATIC DOOR CLOSER(S), TIED TO FIRE ALARM SYSTEM.


  COORDINATE WITH FIRE ALARM FOLIPMENT INSTALLER FOR WIRING REQUIREMENTS PRIOR TO ROLICH IN
- COORDINATE WITH FIRE ALARM EQUIPMENT INSTALLER FOR WIRING REQUIREMENTS PRIOR TO ROUGH IN.
- STAIRWELL PRESSURIZATION FANS ARE INTERLOCKED WITH MOTORIZED SMOKE DAMPERS AND BAROMETRIC RELIEF DAMPERS. REFER TO MECHANICAL PLANS SHEETS AND COORDINATE WITH THE MECHANICAL EQUIPMENT INSTALLER FOR ADDITIONAL INFORMATION.

  BOTH THE PRESSURIZATION FANS AND DAMPERS ARE TO BE CIRCUITED TO THE EMERGENCY POWER SYSTEM AND VIA THE FACP. SEE PANEL EP2 FOR PROPOSED CIRCUITING.

*POWER SHALL BE MONITORED DOWN STREAM OF THE DISCONNECTS.

*PROVIDE CURRENT TRANSDUCER TO MONITOR FAN AIRFLOW (HAWKEYE 608 OR EQUAL).

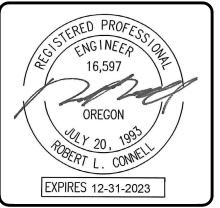

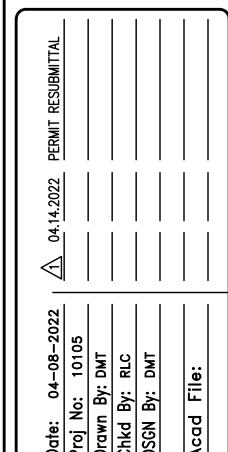

OREGON

RYSTADT 2057 SW PARK AVE.

TLAND

 $\gtrsim$ 



Consulting Engineers 2007 S.E. Ash St. Portland, OR 97214 PHN: (503) 234-0548 FAX: (503) 234-0677 WWW.MFIA-ENG.COM

SHEET

E3.06